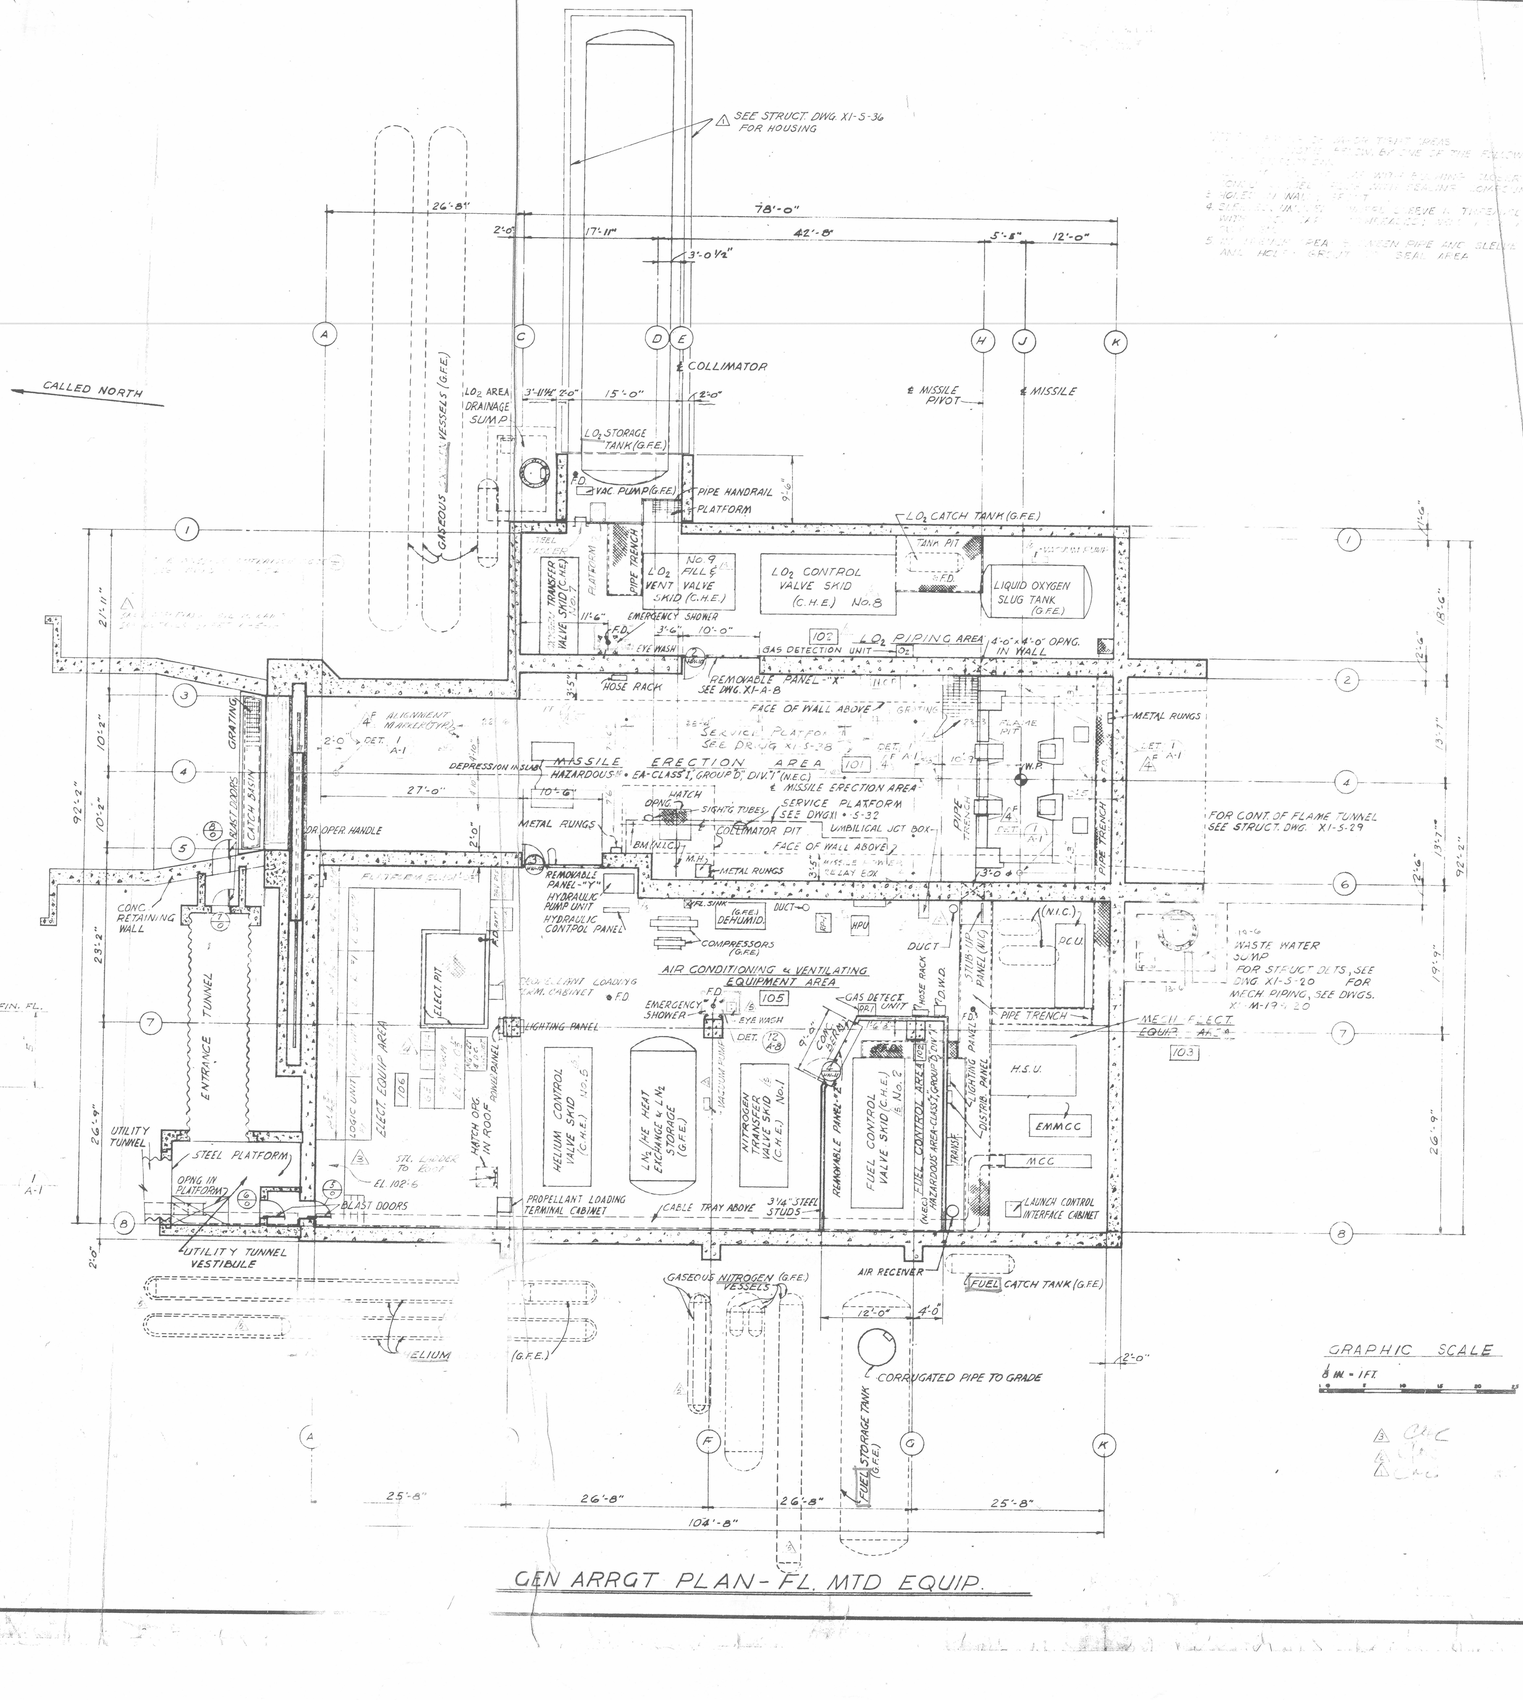

LEGEND

(A) OR (1)	DENOTES COLUMN LINES
(2 / W.D)	DOOR NUMBER - SEE DOOR SCHEDULE; HARDWARE SET
(A / A-1)	SECTION LETTER OR DETAIL NUMBER; DRAWING ON WHICH SECTION OR DETAIL APPEARS
(101)	ROOM FINISH NUMBER - SEE ROOM FINISH & PAINTING SCHEDULE
	DENOTES REINFORCED CONCRETE
	3 1/4" STEEL STUDS @ 16" o.c. & METAL LATH & PLASTER

CONC.	CONCRETE
DET.	DETAIL
D.W.D.	DRINKING WATER DISPENSER
DWG.	DRAWING
EQUIP.	EQUIPMENT
FIN. FL.	FINISH FLOOR
F.D.	FLOOR DRAIN
(G.F.E.)	GOVERNMENT FURNISHED EQUIPMENT - CONTRACTOR INSTALLED
CHGR.	BATTERY CHARGER
JCT.	JUNCTION
EMMCC	ERECTION MECHANISM MOTOR CONTROL CENTER
MACH.	MACHINERY
ELECT.	ELECTRICAL
(N.I.C.)	NOT IN CONTRACT
OPNG.	OPENING
RM.	ROOM
SECT.	SECTION
STRUCT.	STRUCTURAL
VAC.	VACUUM
D.C.	POWER SUPPLY - D.C.
W.P.	WORK POINT
B.M.	BENCH MARK
M.H.	MANHOLE
CHK'D	CHECKERED
PL.	PLATE
MECH.	MECHANICAL
DISTRIB.	DISTRIBUTION
TRANSF.	TRANSFORMER
CONT.	CONTINUATION
LTG.	LIGHTING
(C.H.E.)	CONTRACTOR HOOK-UP TO EQUIPMENT FURNISHED & INSTALLED BY OTHERS.
H.P.U.	HYDRAULIC POWER UNIT
H.S.U.	HYDRAULIC SUPPLY UNIT
M.C.C.	MOTOR CONTROL CENTER
M.G.	MOTOR GENERATOR (400 cps)
N.C.U.	NITROGEN CONTROL UNIT
N.C.P.	NITROGEN CONTROL PANEL
P.C.U.	PRESSURIZATION CONTROL UNIT
O_2	OXYGEN
R.P-1	ROCKET PROPELLANT FUEL
LOX OR LO_2	LIQUID OXYGEN
(N.E.C.)	NATIONAL ELECTRIC CODE

NOTE:

SEE CIVIL DRAWINGS FOR BUILDING ORIENTATION, LOCATION ON SITE, FINISH FLOOR & FINISH GRADE ELEVATIONS.

4 DENOTES CHANGE ACCOMPLISHED BY FIELD.

REVISION	DATE	DESCRIPTION	AGENCY	INIT.
5	6-4-59	REVISED AS BUILT DWG. NOTES, SECTION, DETS.		
4	5-21-59	GENERAL REVISION - CONSTRUCTION AS BUILT DWG.	A.F.B.	
3	4-10-59	ADDED WATER LINE AND ASSOC. PIPING PER CO FOR A-22	USAF	
2	3-5-59	ADDED MISSILE CENTERLINE MARKER PER CO FOR-21	USAF	
1	1-15-59	ADDED PLATFORMS, MOVED & RELOCATED ELECT. EQUIPT.	BECHTEL	
		ELEC. WORK PER CHANGE NO. 3 TO A.T.P.		
1	7-22-58	ADDED HOUSING FOR LIQ OXYGEN STOR. TANK.	BECHTEL	

BECHTEL CORPORATION
ENGINEERS AND CONSTRUCTORS
SAN FRANCISCO — LOS ANGELES — NEW YORK

DEPARTMENT OF THE AIR FORCE
AIR FORCE BALLISTIC MISSILE DIVISION (ARDC)
INGLEWOOD, CALIFORNIA

		DATE
DESIGNED BY	R. PAUL	11-24-58
DRAWN BY	R. PAUL	11-24-58
CHECKED BY	LIEBI	1-30-59
O.K.	[illegible]	5-21-59
O.K.	[illegible]	5-21-59
APPROVED	BECHTEL CORP.	5-21-59

WS 107 A-1 OPERATIONAL BASE
FORBES A.F.B. KANSAS
COMPLEXES D, E, F, G, H & I
LAUNCH & SERVICE BUILDING
GEN ARRGT PLAN-FL MTD EQUIP.

APPROVED FOR AFBND — DATE

SPECIFICATION No. OC-59-72
DATE 21 MAY 1959 — SCALE 1/8" = 1'-0"
DRAWING NUMBER 3115-3 — SHEET XI-A-1

INDEX NO.