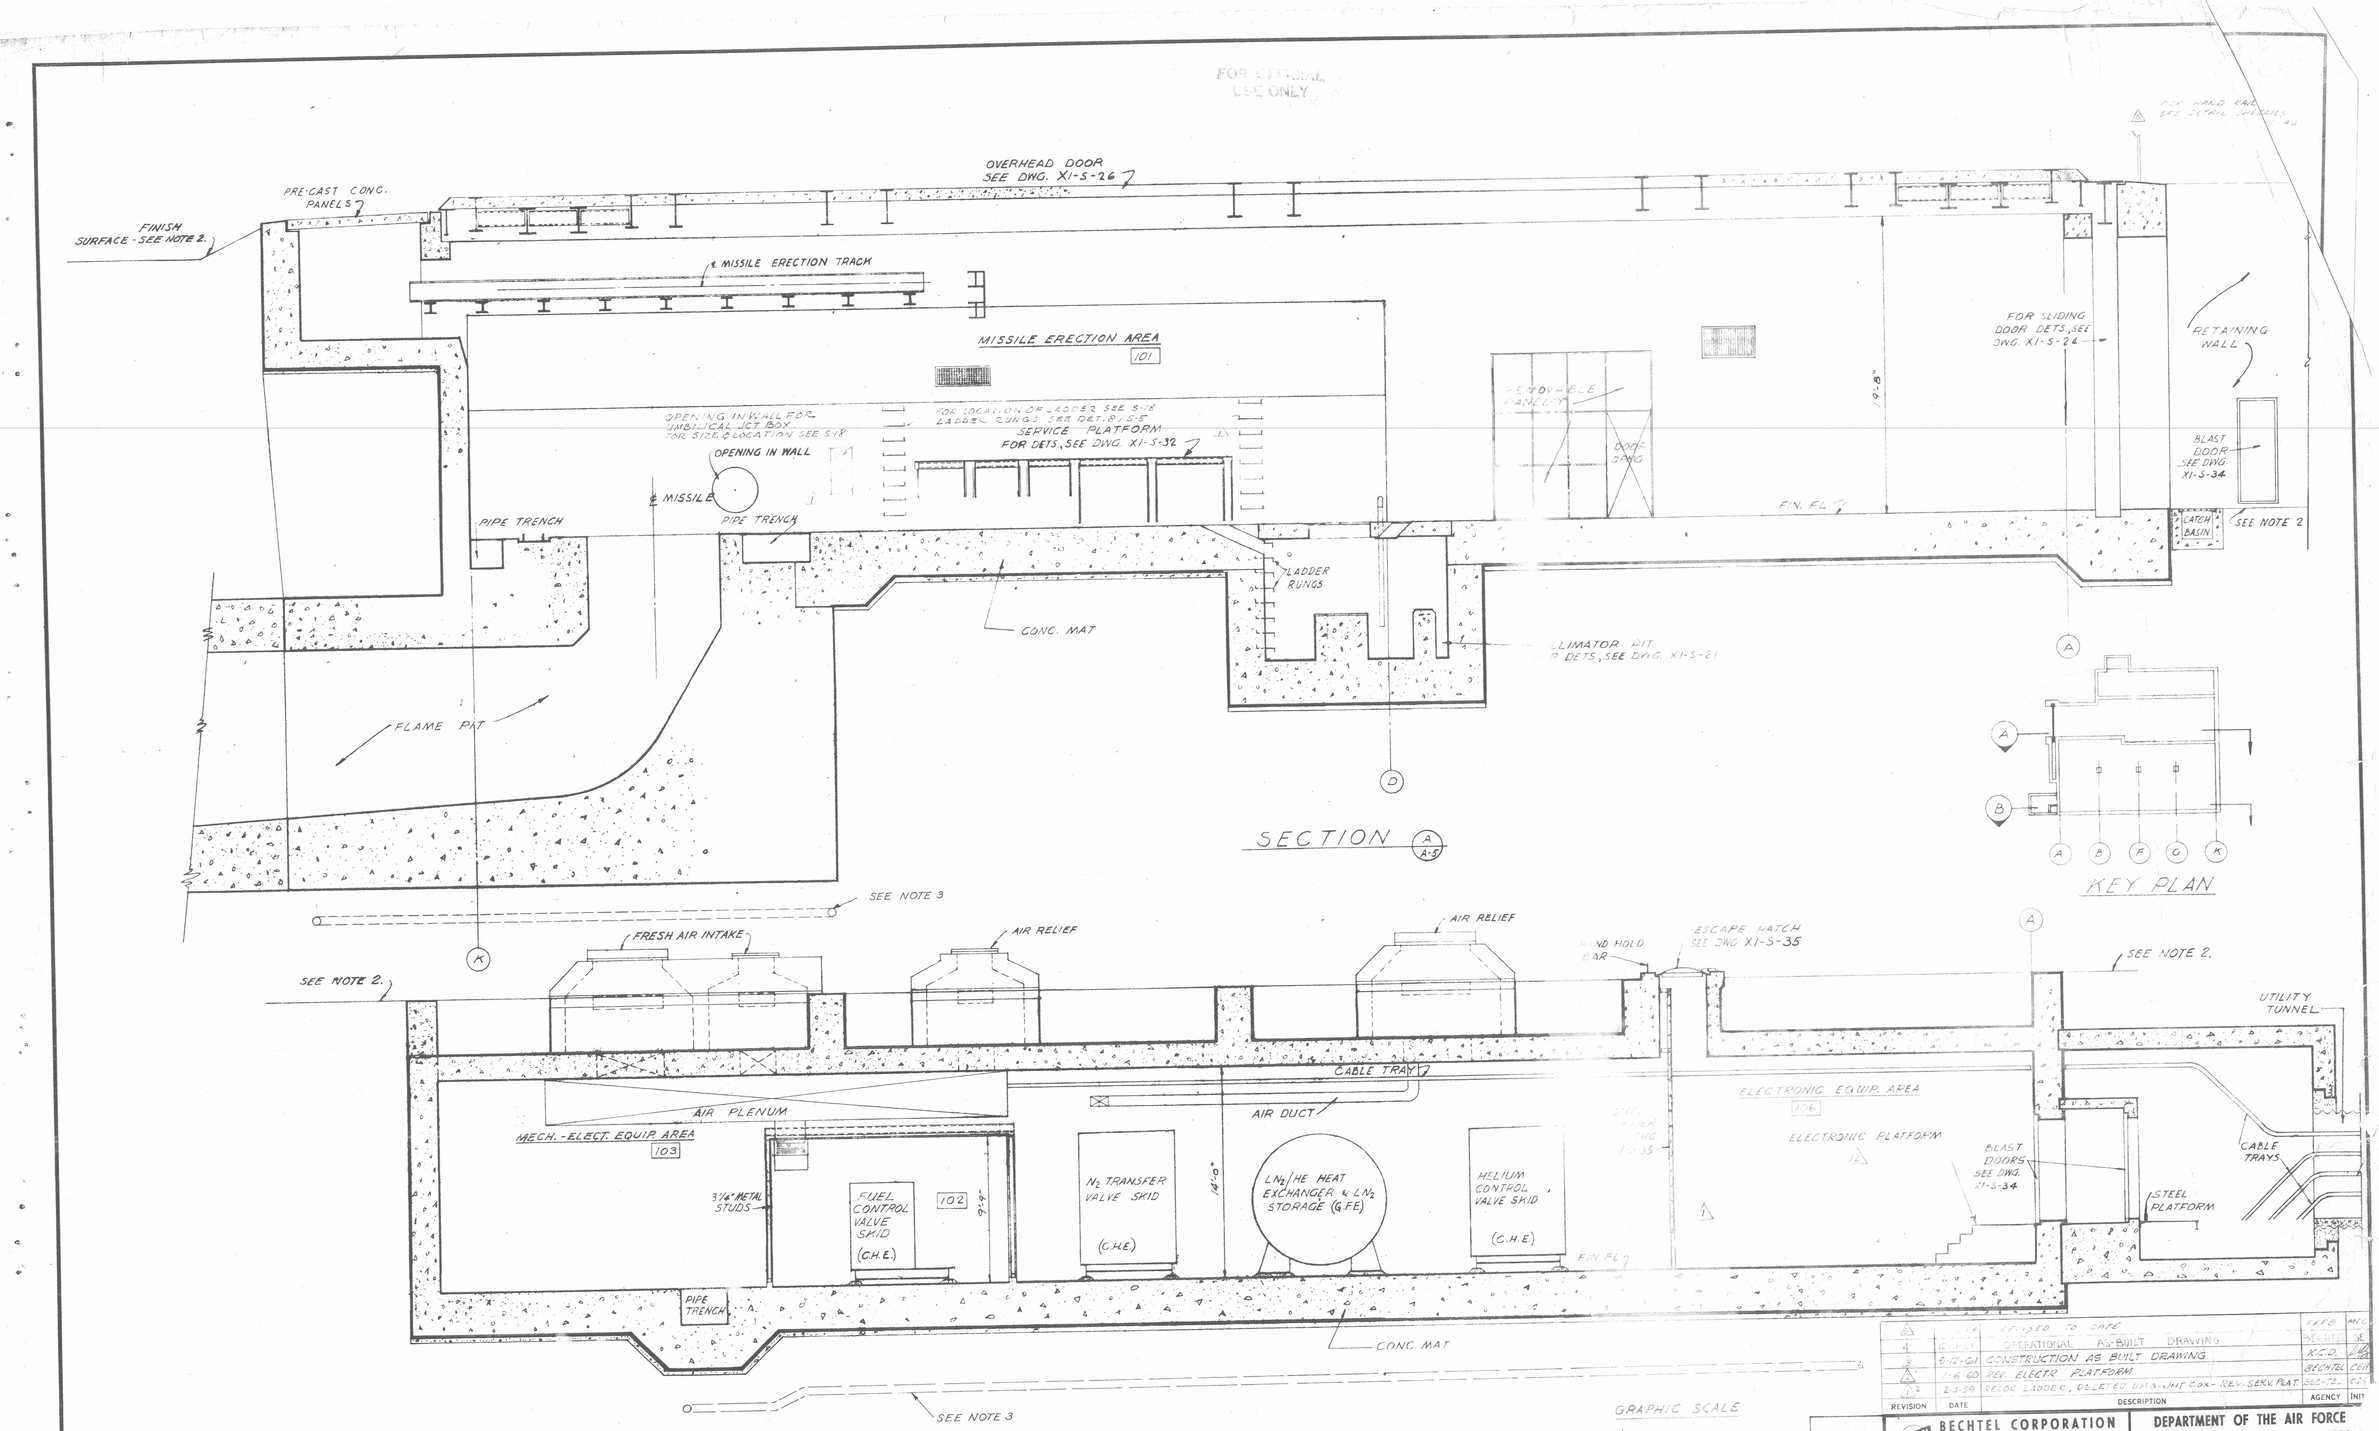

NOTES:

1. FOR WATERPROOFING MEMBRANE & 2" THICK LEAN CONC. BASE SLAB - SEE GEN. NOTES ON DWG. X1-S-1.
2. FINISH SURFACE - FOR EXTENT OF EXCAVATION, BACKFILL, GRADING & PAVING, SEE CIVIL DWGS.
3. FOR SUB-DRAINS, COMPLEXES F, G, H & I, SEE DWG. X3-C-11 & DWG. E3-C-14 FOR COMPLEX E.

FOR OFFICIAL USE ONLY

REVISION	DATE	DESCRIPTION	AGENCY	INIT
5	[illegible]	REVISED TO DATE	FFFB	MTC
4	[illegible]	OPERATIONAL AS-BUILT DRAWING	BECHTEL	SE
3	5-12-61	CONSTRUCTION AS BUILT DRAWING	K.C.D.	
2	1-6-60	REV. ELECTR. PLATFORM	BECHTEL	CEH
1	12-4-59	RELOC. LADDER, DELETED UMB. JMT. BOX - REV. SERV. PLAT.	BECHTEL	CTS

BECHTEL CORPORATION
ENGINEERS AND CONSTRUCTORS
SAN FRANCISCO — LOS ANGELES — NEW YORK

DEPARTMENT OF THE AIR FORCE
AIR FORCE BALLISTIC MISSILE DIVISION (ARDC)
INGLEWOOD, CALIFORNIA

		DATE
DESIGNED BY	R. PAUL	10-19-58
DRAWN BY	R. PAUL	10-19-58
CHECKED BY	LIEBI	1-30-59
O.K.	[illegible]	5-21-59
O.K.	G. Gidlow	5-21-59
APPROVED	BECHTEL CORP.	5-21-59

WS 107 A-1 OPERATIONAL BASE

FORBES A.F.B. KANSAS

COMPLEXES D, E, F, G, H & I

LAUNCH & SERVICE BUILDING

GEN ARRGT - BUILDING SECTIONS

SPECIFICATION No. ENG-23-028-59-

DATE 21 MAY 1959 | SCALE AS SHOWN

DRAWING NUMBER 3115-3 X1-A-5

SHEET

BMD INDEX No. 5D1.6.1

APPROVED BY

FOR

APPROVED

AFBMD

DATE