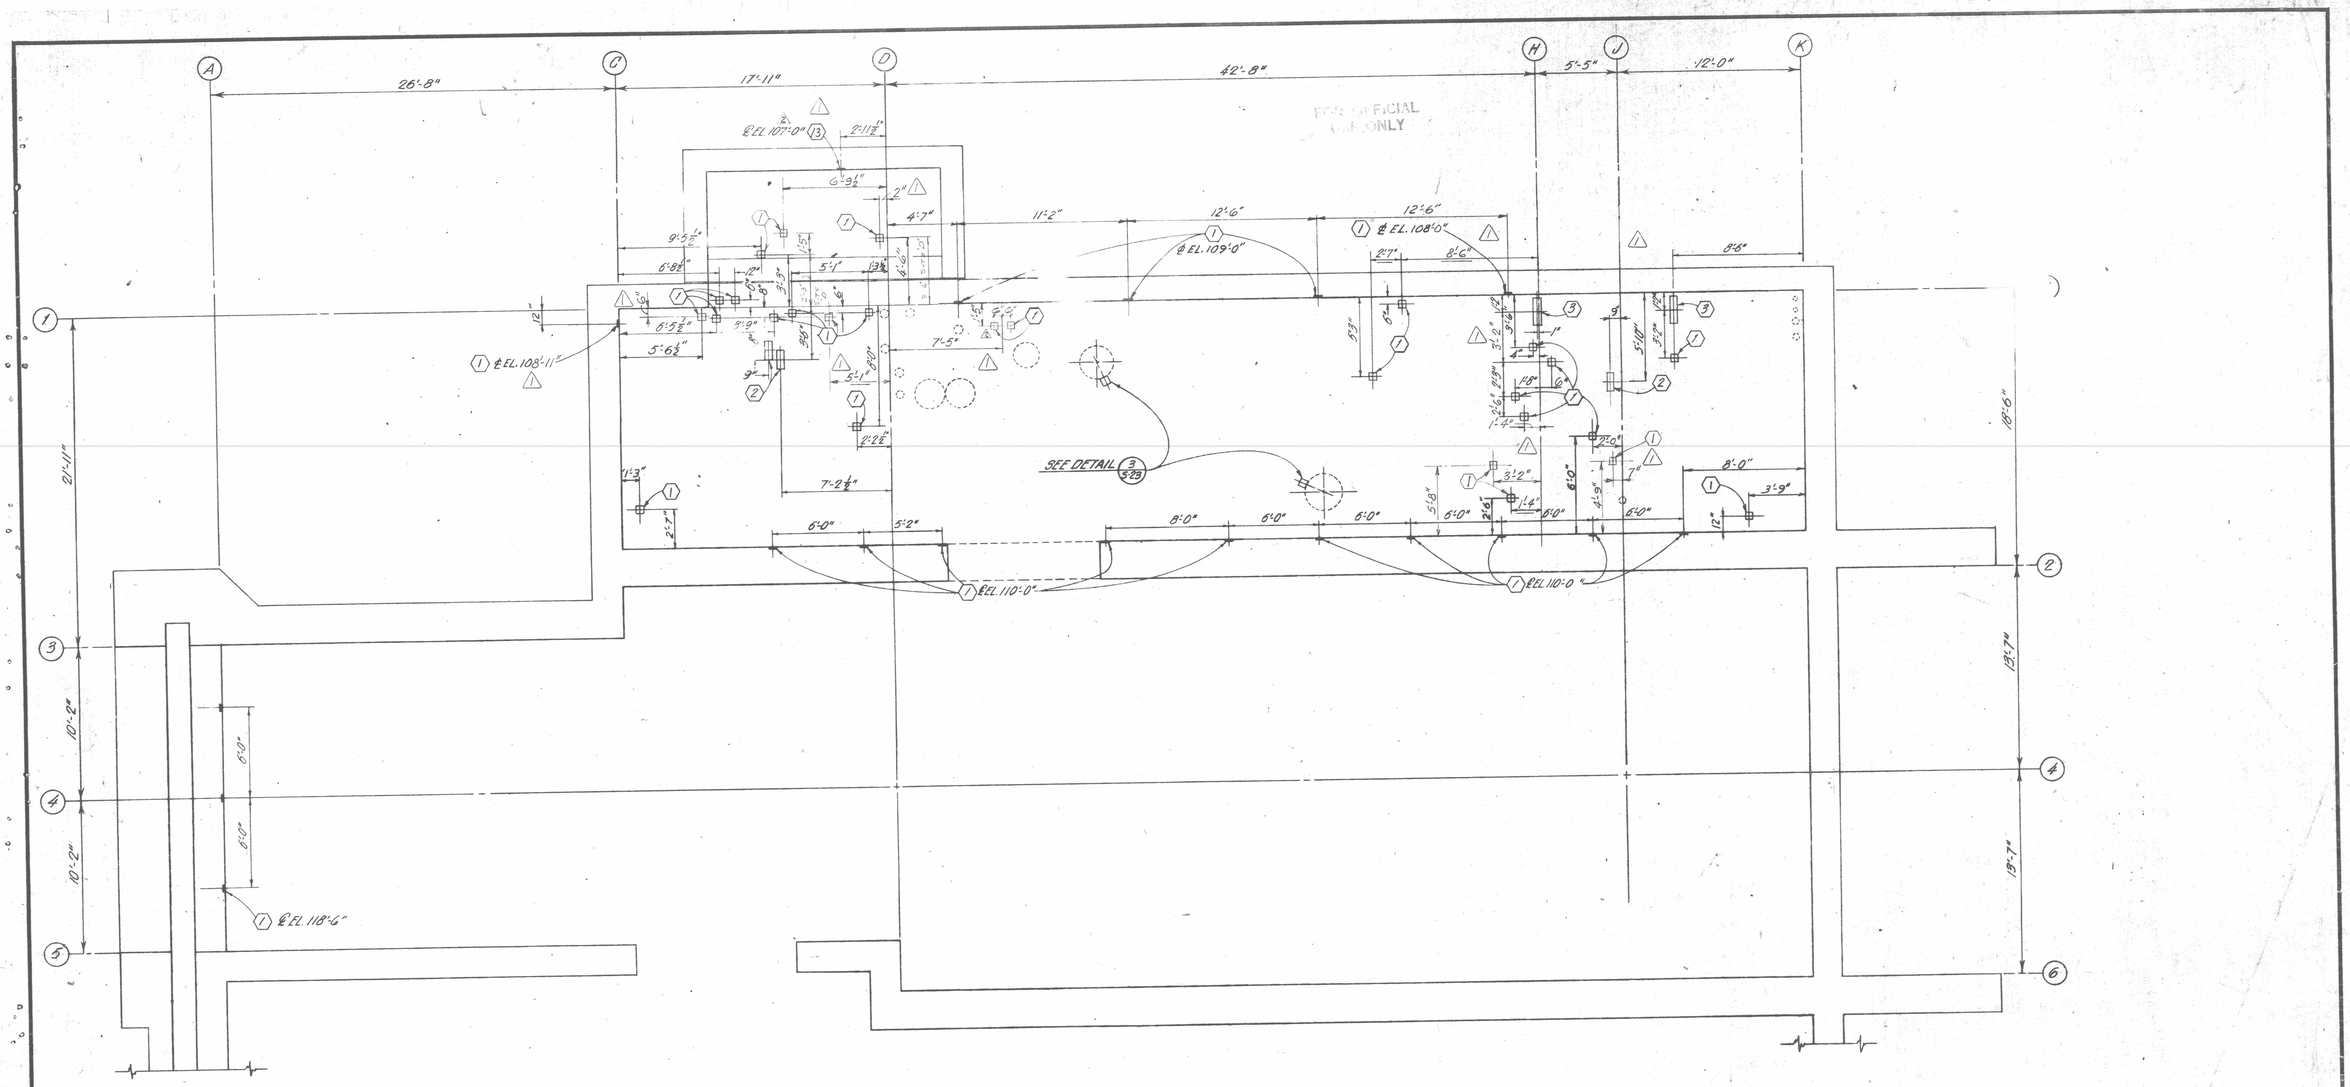

PARTIAL REFLECTED CEILING PLAN
SCALE: 1/4"=1'-0"

NOTES:
1: FACE OF ALL INSERTS SET FLUSH WITH SURFACE OF CONCRETE.
2: FOR TYPE (1), (2), (3) & (13) INSERT I.D.'S. SEE DET. (1/S-29)

1 0 2 4 6 8 10
1/4 IN.=1 FT.

FOR OFFICIAL USE ONLY

REVISION	DATE	DESCRIPTION	AGENCY	INIT.
△	12-11-61	OPERATIONAL AS-BUILT DRAWING	BECHTEL	SE
△2	5-12-61	REVISED ELEV. OF ℄ EL. 107'-0" & COL. LINE "D" AND RELOCATED INSERTS - CONST. AS BUILT DWG.	K.J.D.	KJD
△1	3 SEPT. 59	REVISED INSERT PLATES	BECHTEL	BDE

BECHTEL CORPORATION
ENGINEERS AND CONSTRUCTORS
SAN FRANCISCO — LOS ANGELES — NEW YORK

DEPARTMENT OF THE AIR FORCE
AIR FORCE BALLISTIC MISSILE DIVISION (ARDC)
INGLEWOOD, CALIFORNIA

		DATE
DESIGNED BY	Paul	1-30-59
DRAWN BY	Whitelow	1-30-59
CHECKED BY	BERRIGAN	1-30-59
O.E.	GUSTAFSON	5-21-59
O.E.	G. Gideon	5-21-59
APPROVED		5-21-59
BECHTEL CORP.		

WS-107 A-I OPERATIONAL BASE

FORBES A.F.B. KANSAS
COMPLEX D, E, F, G, H & I
LAUNCH & SERVICE BUILDING
PIPE SUPPORTS - PART I

APPROVED FOR: Paul L. Lockey, Captain USAF, Chief, Facilities Engineering Div. — DATE
Jack H. Carter, Capt. USAF, Chief, Facilities Engineering Div. — DATE
Lt. Col. USAF, AFBMD — DATE

SPECIFICATION No. ENG. 23-028-59-
DATE 21 MAY 1959 SCALE 1/4"=1'-0"
DRAWING NUMBER 3115-3 X1-S-22
SHEET

APPROVED BY: C. H. C. 20 SEP 1959
CLEAR INSTALLATIONS OFFICER
U.S. Army Engr. Dist., Los Angeles
REVIEWED FOR CONSTRUCTION FEASIBILITY
FOR THE CHIEF OF ENGINEERS
21 MAY 1959
CLINTON H. CHAMBERLAIN, JR.
Lt. Col., Corps of Engineers
Assistant District Engineer (AMPO)

FOR OFFICIAL USE ONLY

AMD INDEX No. 5016.1