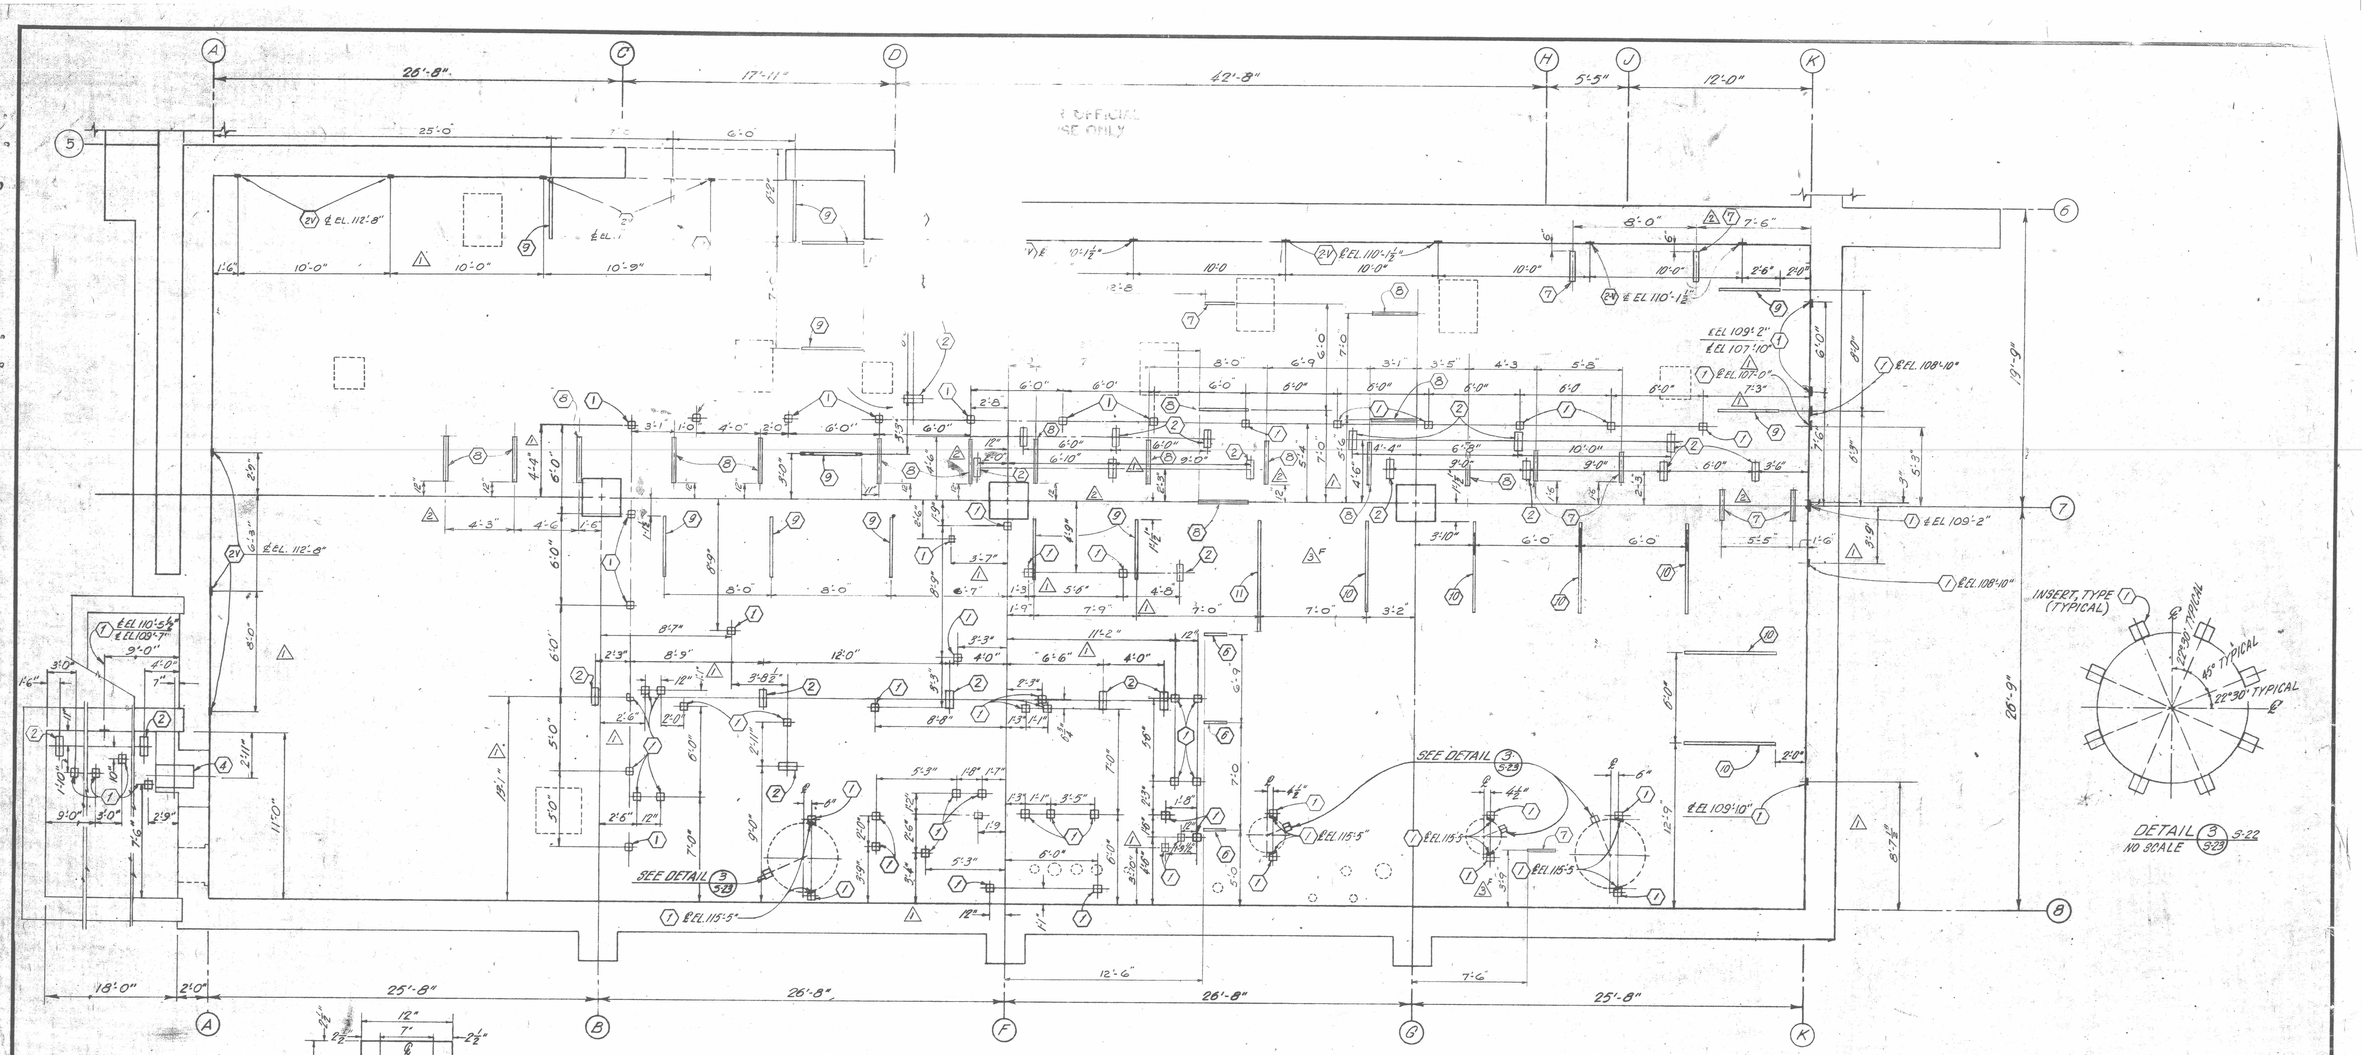

PARTIAL REFLECTED CEILING PLAN
SCALE: ¼"=1'-0"

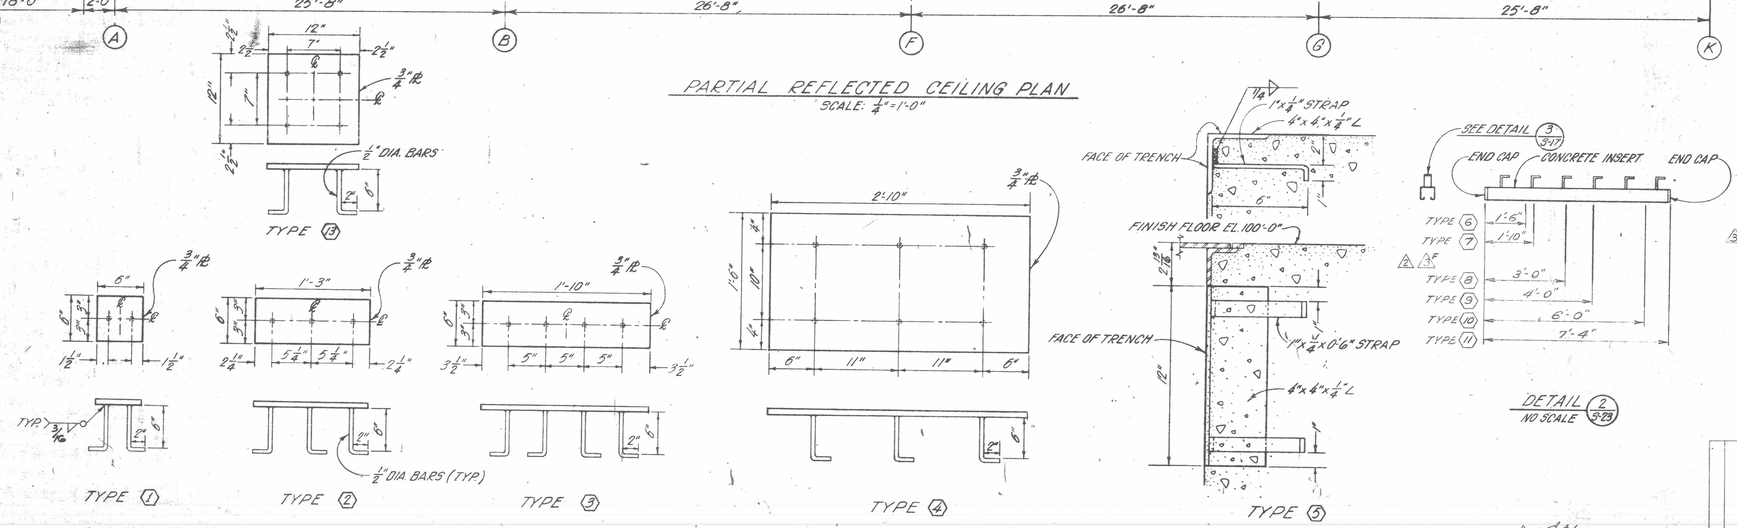

NOTES:

1. FACE OF ALL INSERTS SET FLUSH WITH SURFACE OF CONCRETE.
2. TYPE (6) THRU (11) FOR ELECTRICAL EQUIPMENT ONLY. SEE DETAIL 2/S-23
3. TYPE (2V) DENOTES TYPE (2) INSERT WITH LONG AXIS VERTICAL.
4. TYPE (2H) DENOTES TYPE (2) INSERT WITH LONG AXIS HORIZONTAL.
5. TYPE (1) THRU (5) SEE DETAIL 1/S-23

△F DENOTES CHANGE ACCOMPLISHED BY FIELD

¼" IN = 1 FT.

1½" IN = 1 FT

REVISION	DATE	DESCRIPTION	AGENCY	INIT.
△4	3-31-61	CONSTRUCTION AS BUILT DRAWING	K.C.D.	
△3	3-10-60	REV. ALL ELECT. INSERTS - DELETED TYPE 12 - PER C.O. - FEB. 59	BECHTEL	T.F.
△2	1-4-60	REVISED INSERT PLATES	BECHTEL	C.F.P.
△1	8-20-59	GENERAL REVISION OF INSERT PLATES	BECHTEL	J.L.

BECHTEL CORPORATION
ENGINEERS AND CONSTRUCTORS
SAN FRANCISCO — LOS ANGELES — NEW YORK

DEPARTMENT OF THE AIR FORCE
AIR FORCE BALLISTIC MISSILE DIVISION (ARDC)
INGLEWOOD, CALIFORNIA

		DATE
DESIGNED BY	Polvi	1-30-59
DRAWN BY	Whitelaw	1-30-59
CHECKED BY	Berrien	1-30-59
O.K.	Gustafson	2-20-59
O.K.	Gibson	2-20-59
APPROVED		2-20-59
	BECHTEL CORP.	

WS-107 A-I OPERATIONAL BASE

FORBES A.F.B. KANSAS

COMPLEX A, B & C
LAUNCH & SERVICE BUILDING
PIPE SUPPORTS - PART 2

SPECIFICATION No. ENG. 23-028-59-64

DATE 26 MARCH 1959 | SCALE AS NOTED

DRAWING NUMBER: 3115-1 XI-S-23 | SHEET

APPROVED FOR — AFBND

△5 12-11-61 OPERATIONAL AS-BUILT DRAWING BECHTEL SF

APPROVED BY — 30 Ga 1111 121

JAN 22 1960

16 SEP 1960

CHIEF, MISSILES OFFICE
U.S. Army Engr. Div., Pac. Los Angeles
APPROVED FOR CONSTRUCTION FEASIBILITY FOR THE CORPS OF ENGINEERS
20 JAN 1960
CLIFFORD H. CHAMBERLAIN, JR.
Lt. Col., Corps of Engineers
Assistant District Engineer (AFMPD)

FOR OFFICIAL USE ONLY

FOR OFFICIAL USE ONLY