FOR OFFICIAL USE ONLY

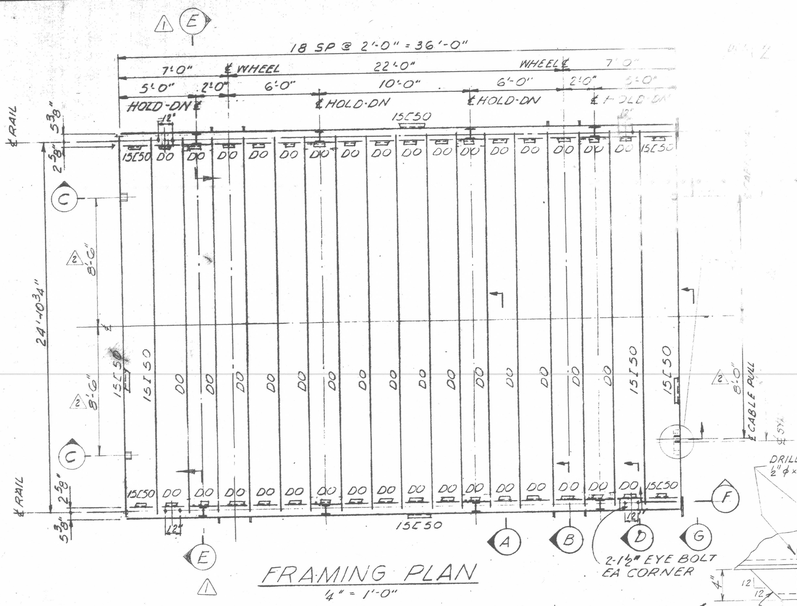

FRAMING PLAN
4" = 1'-0"

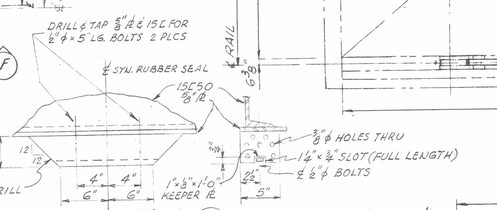

DETAIL (2)
1½" = 1'-0"

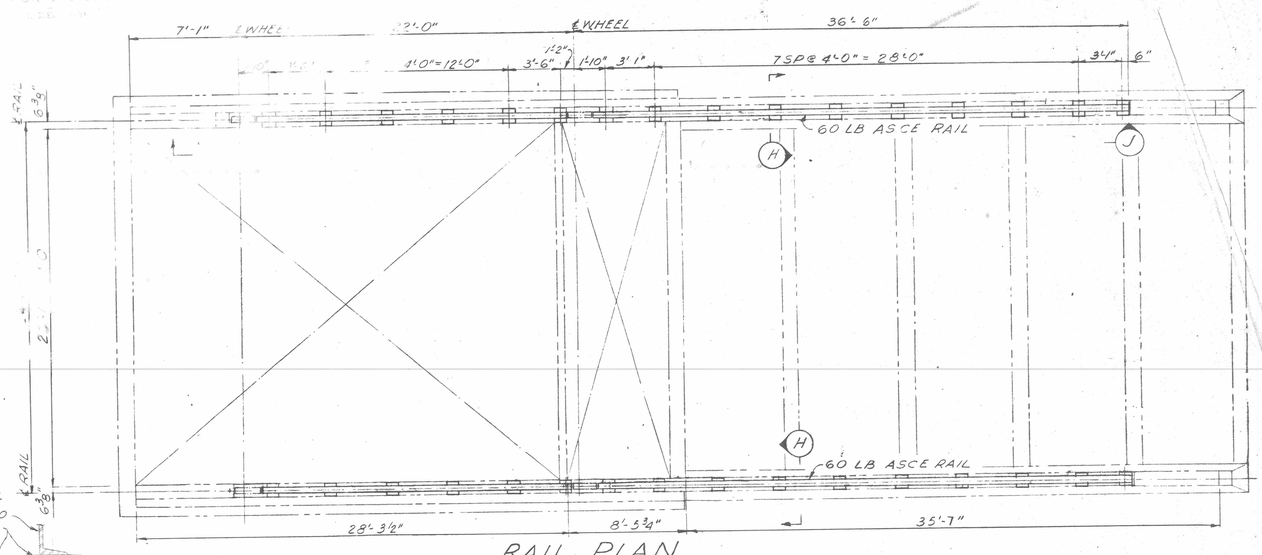

RAIL PLAN
¼" = 1'-0"

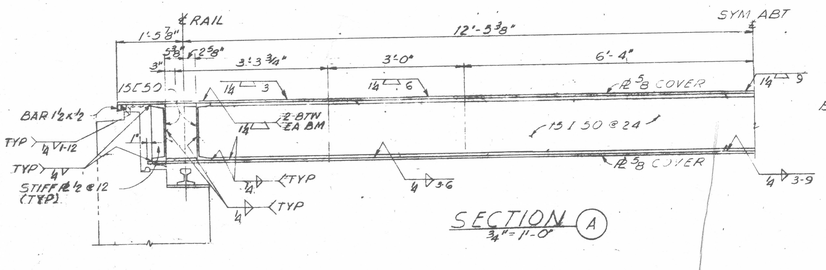

SECTION (A)
¾" = 1'-0"

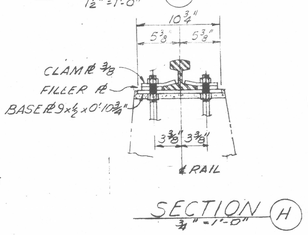

SECTION (H)
¾" = 1'-0"

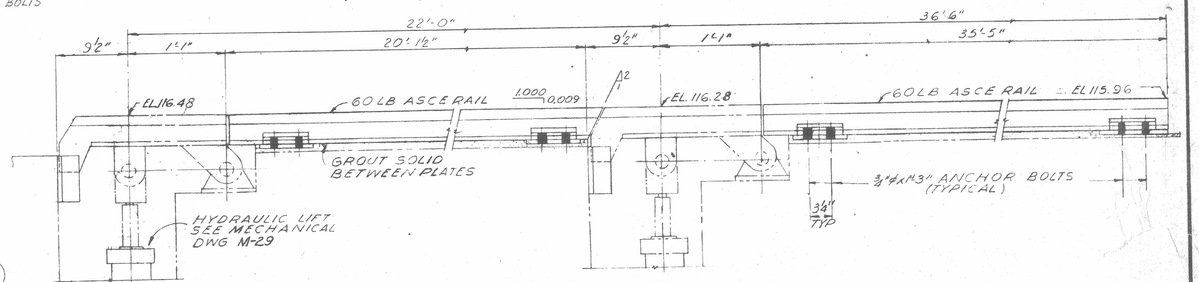

SECTION (J)
NO SCALE

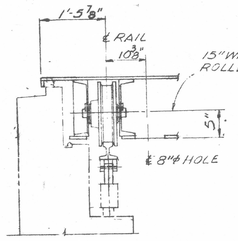

SECTION (B)
¾" = 1'-0"

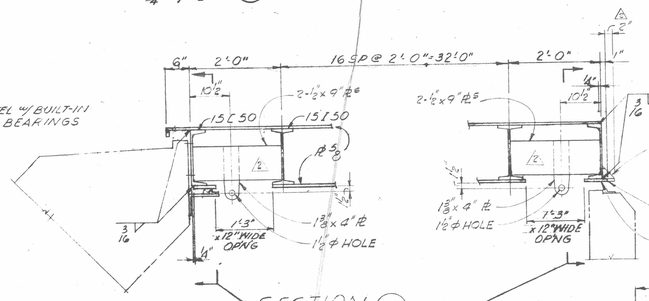

SECTION (C)
¾" = 1'-0"

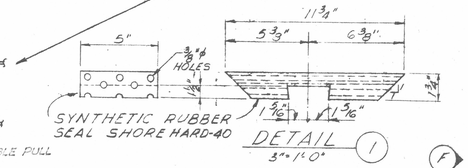

DETAIL (I)
3" = 1'-0"

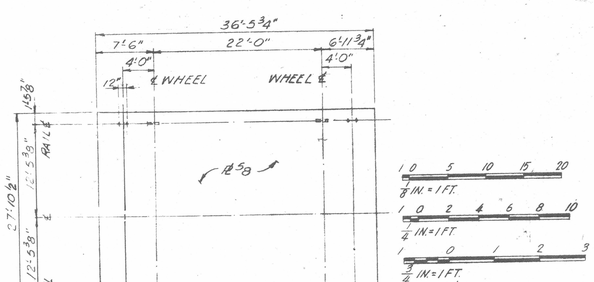

PLAN - TOP PLATE
⅛" = 1'-0"

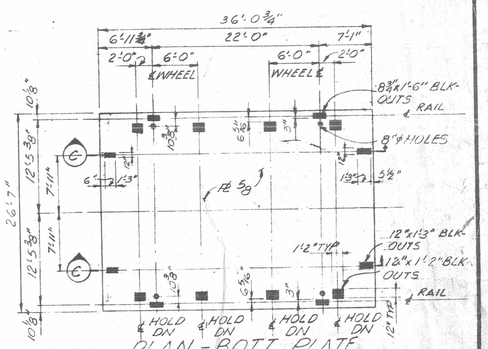

PLAN - BOTT PLATE
⅛" = 1'-0"

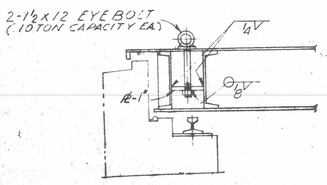

SECTION (D)
¾" = 1'-0"

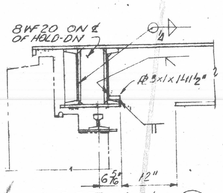

SECTION (E)
¾" = 1'-0"

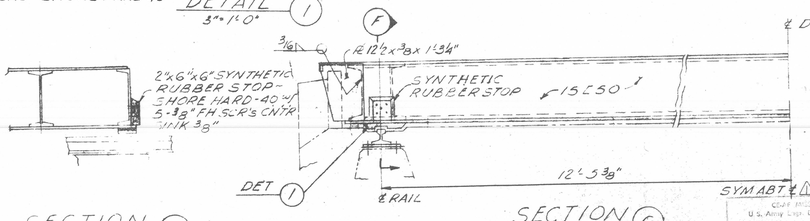

SECTION (F)
¾" = 1'-0"

SECTION (G)
¾" = 1'-0"

FOR OFFICIAL USE ONLY
U.S. Army Engr. District, Omaha
REVIEWED FOR THE CHIEF OF ENGINEERS
21 MAY 1959
CHIEF, ENGINEERING DIVISION
Alternate (Acting)
BMD INDEX No. 5.D1.6.1
APPROVED FOR

REVISION	DATE	DESCRIPTION	AGENCY	INIT.
2	12-11-61	OPERATIONAL AS-BUILT DRAWING	BECHTEL	S.E.
1	5-12-61	REV. SECT. "C" & FRAMING PLAN - CONST. AS BUILT DWG.	K.C.D.	K.C.D.
14	3 Sept. 59	ADDED DET. 2, ADDED SEC. E ON FRAMING PLAN	BECHTEL	E.D.E.

BECHTEL CORPORATION
ENGINEERS AND CONSTRUCTORS
SAN FRANCISCO — LOS ANGELES — NEW YORK

DEPARTMENT OF THE AIR FORCE
AIR FORCE BALLISTIC MISSILE DIVISION (ARDC)
INGLEWOOD, CALIFORNIA

		DATE
DESIGNED BY	Tufts	1-30-59
DRAWN BY	KREIDER	1-30-59
CHECKED BY	Berrien Hoff	1-30-59
O.K.	Mustafiom	5-21-59
O.K.	G Gideon	5-21-59
APPROVED	BECHTEL CORP.	5-21-59

WS-107 A-1 OPERATIONAL BASE
FORBES A.F.B. KANSAS
COMPLEX D, E, F, G, H & I
LAUNCH & SERVICE BUILDING
FLAME TUNNEL DOOR

APPROVED FOR AFBMD
DATE
SPECIFICATION No. ENG-23-028-59-
DATE 21 MAY 1959
SCALE AS NOTED
DRAWING NUMBER 3115-3
SHEET XI-S-28