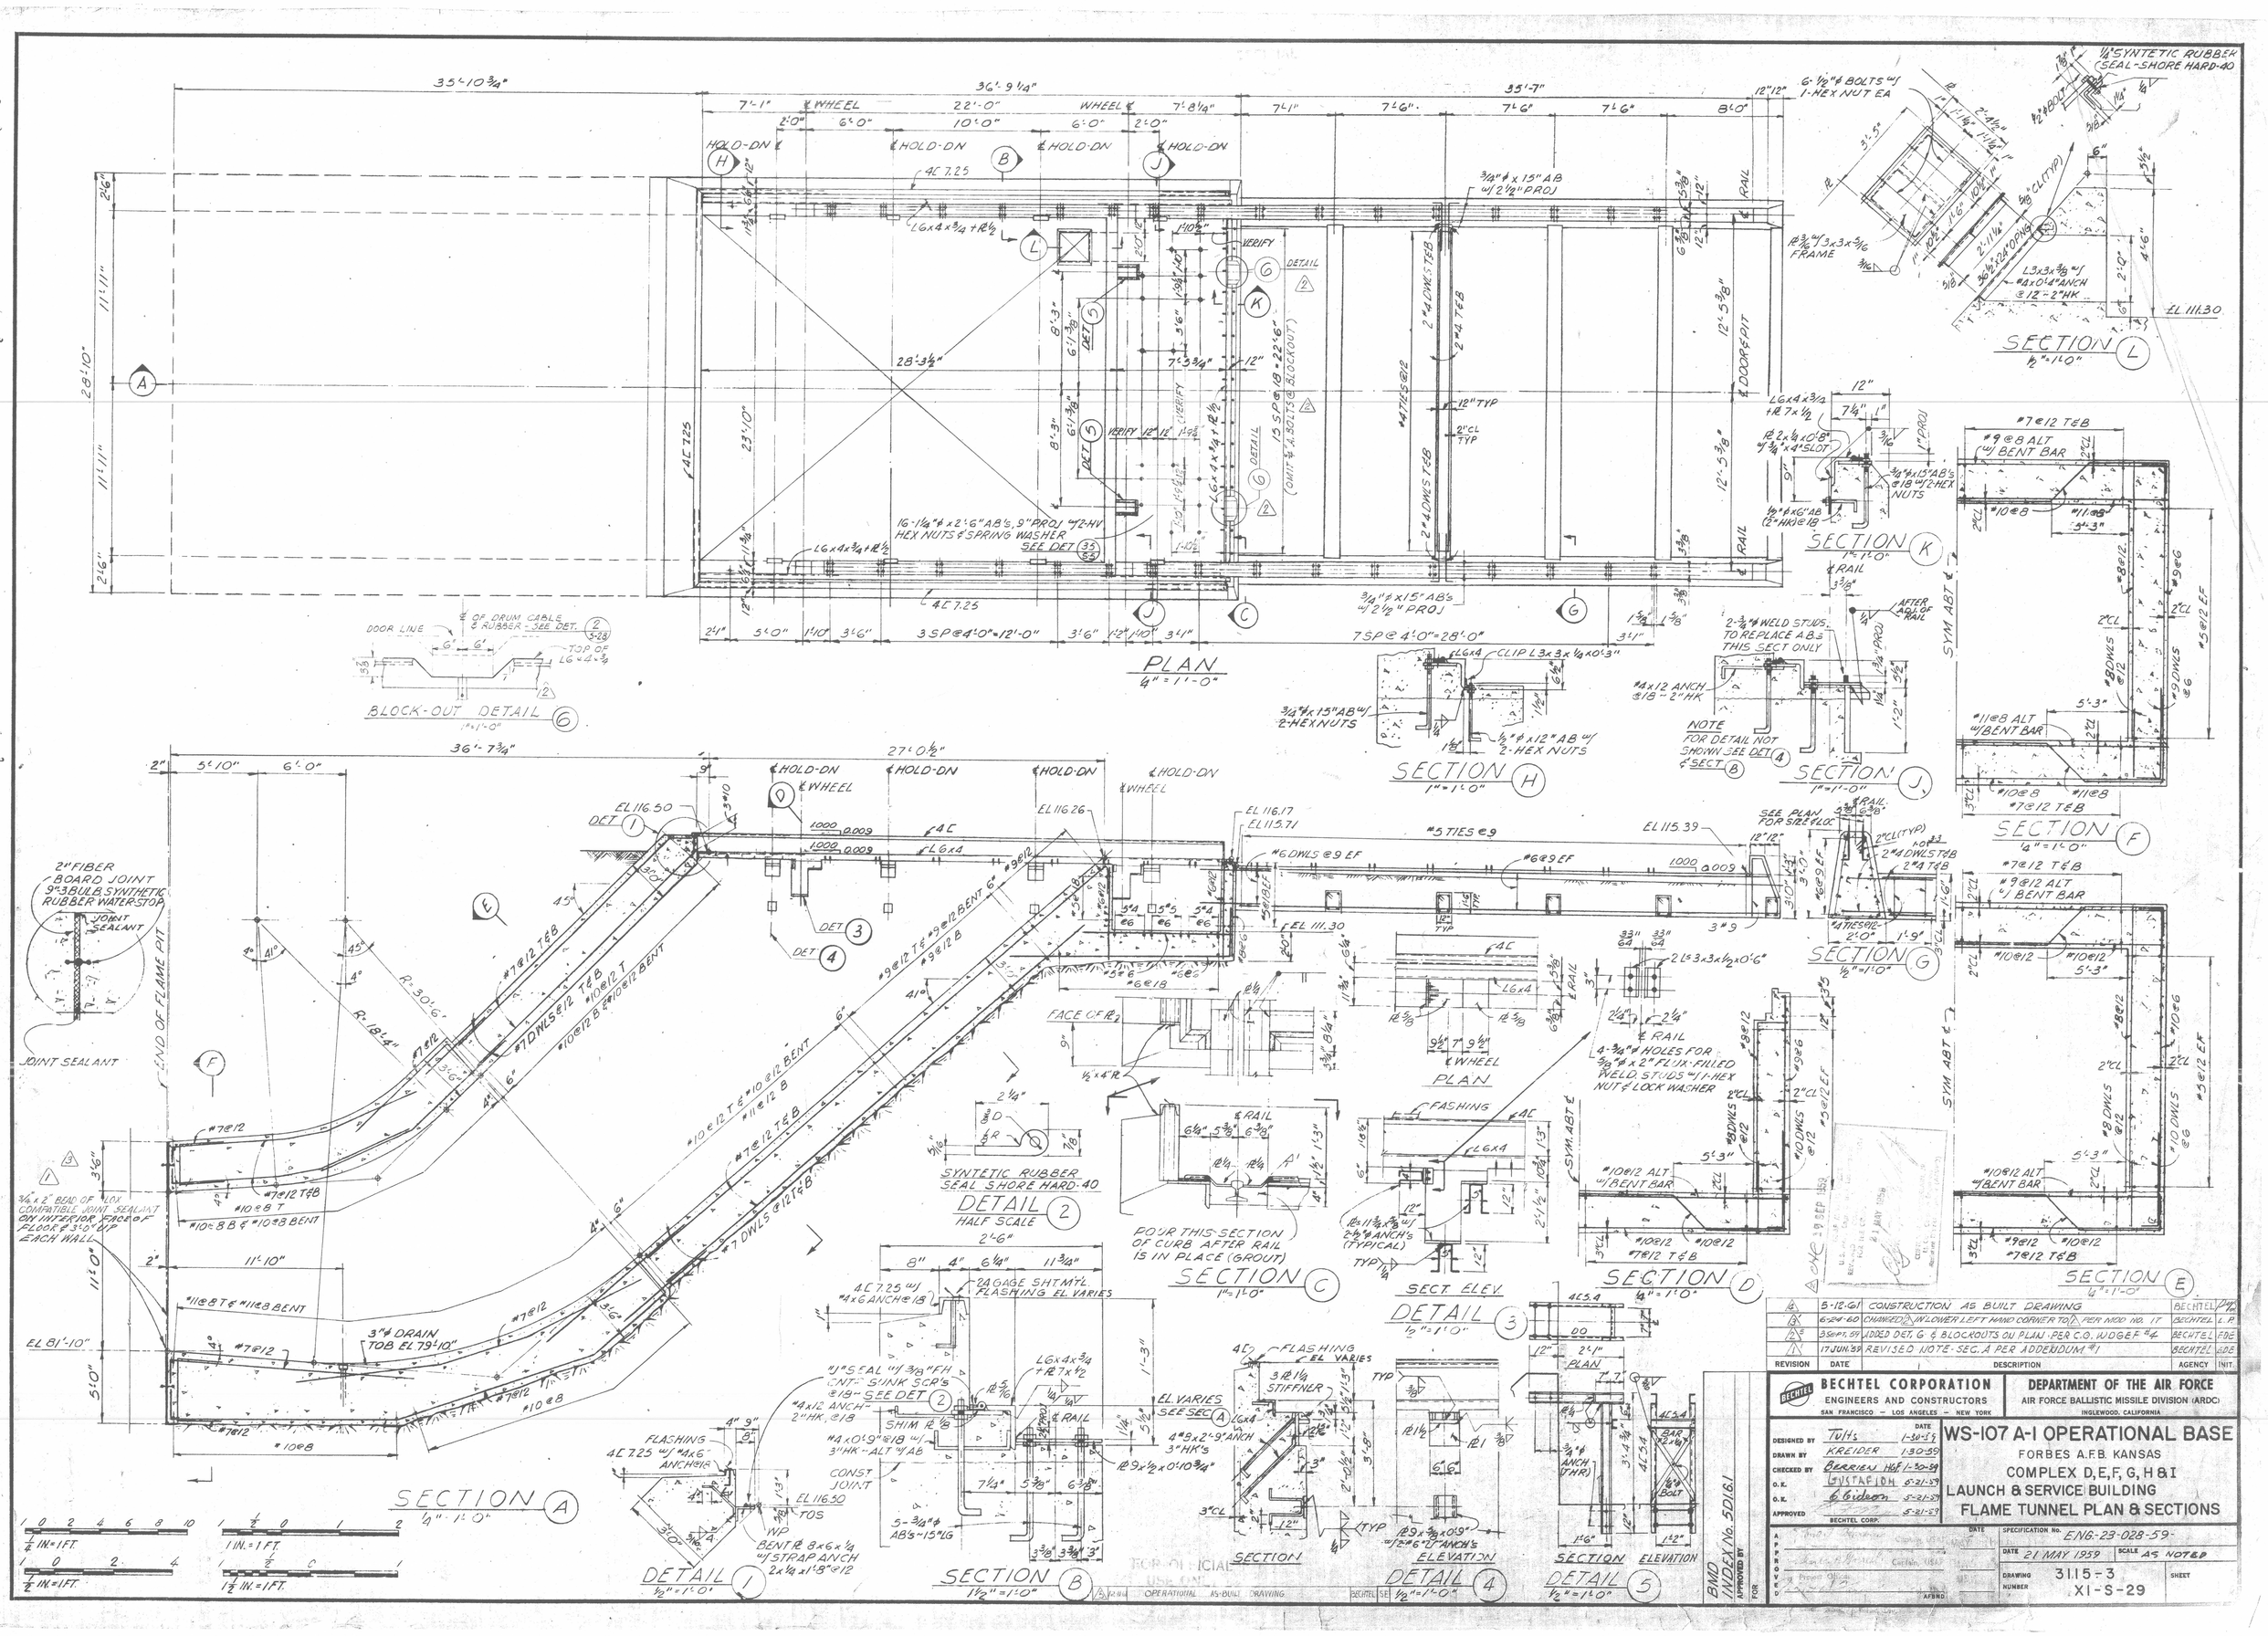

REVISION	DATE	DESCRIPTION	AGENCY	INIT.
16	5-12-60	CONSTRUCTION AS BUILT DRAWING	BECHTEL	
15	6-24-60	CHANGED 2 IN LOWER LEFT HAND CORNER TO 1 PER MOD NO. 17	BECHTEL	L.P.
14	3 SEP 59	ADDED DET. G & BLOCKOUTS ON PLAN - PER C.O. WDGE.F. #4	BECHTEL	FDE
13	17 JUN 59	REVISED NOTE - SEC. A PER ADDENDUM #1	BECHTEL	GDE

BECHTEL CORPORATION
ENGINEERS AND CONSTRUCTORS
SAN FRANCISCO — LOS ANGELES — NEW YORK

DEPARTMENT OF THE AIR FORCE
AIR FORCE BALLISTIC MISSILE DIVISION (ARDC)
INGLEWOOD, CALIFORNIA

WS-107 A-I OPERATIONAL BASE

FORBES A.F.B. KANSAS

COMPLEX D, E, F, G, H & I

LAUNCH & SERVICE BUILDING

FLAME TUNNEL PLAN & SECTIONS

		DATE
DESIGNED BY	TUHS	1-30-59
DRAWN BY	KREIDER	1-30-59
CHECKED BY	BERRIEN HOF	1-30-59
O.K.	GUSTAFSON	5-21-59
O.K.	G Gibson	5-21-59
APPROVED	BECHTEL CORP.	5-21-59

APPROVED FOR AFBMD — DATE

SPECIFICATION No. ENG-23-028-59

DATE 21 MAY 1959 — SCALE AS NOTED

DRAWING NUMBER 3115-3 XI-S-29 — SHEET

BMD INDEX No. 5D16.1

APPROVED BY

FOR OFFICIAL USE ONLY

OPERATIONAL AS-BUILT DRAWING — BECHTEL SE