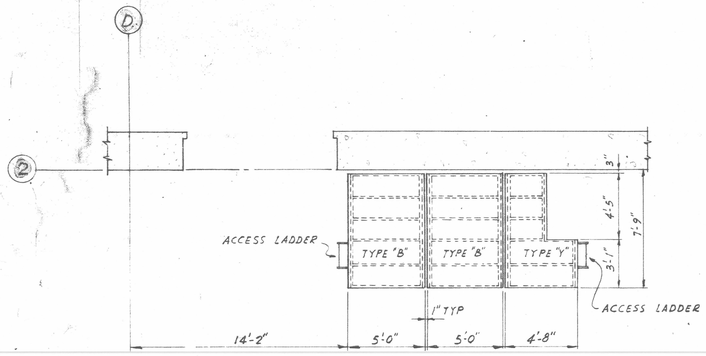

PLATFORM ARRANGEMENT PLAN
1/4" = 1'-0"

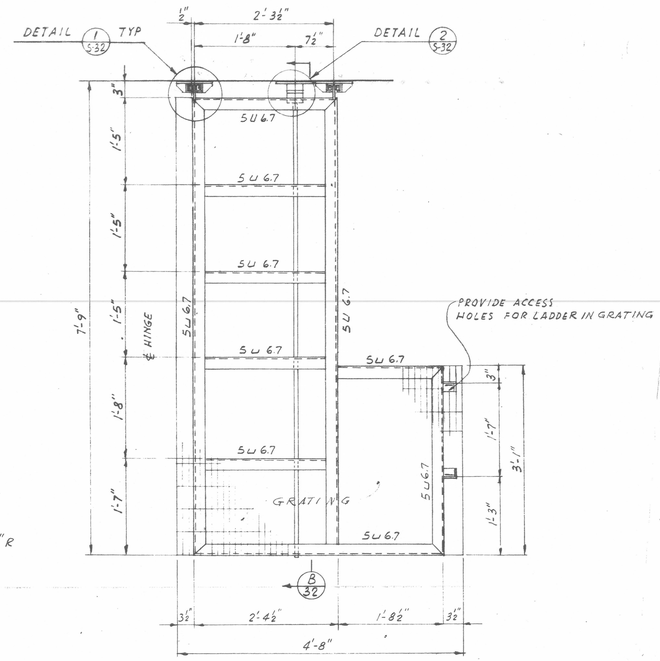

PLAN TYPE "Y"
1" = 1'-0"

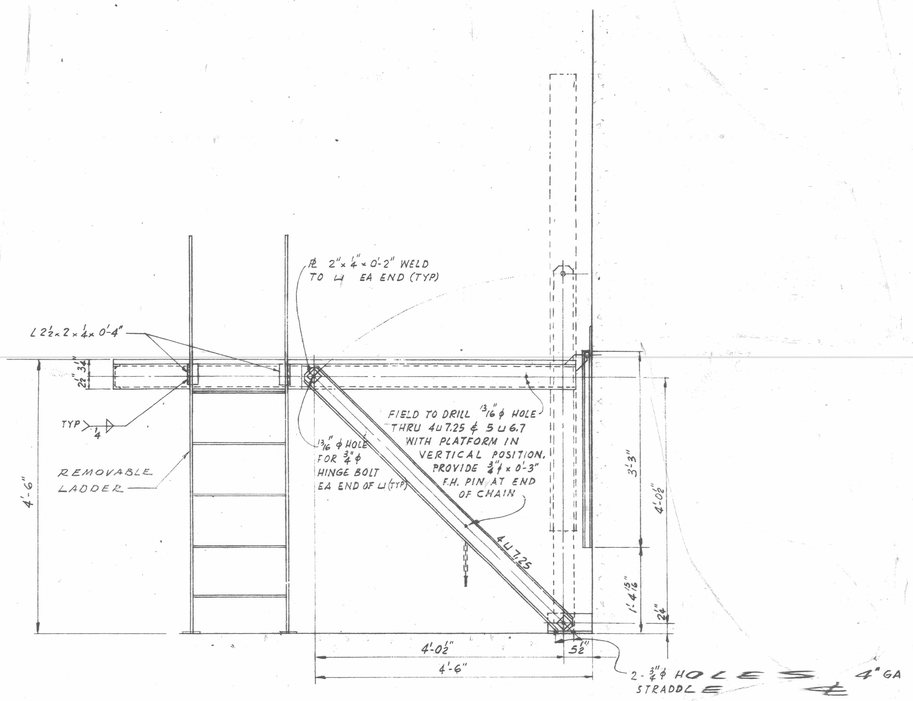

SIDE ELEVATION TYPE "Y"
1" = 1'-0"

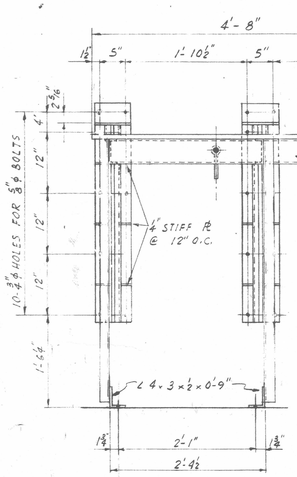

FRONT ELEVATION. TYPE "Y"
1" = 1'-0"

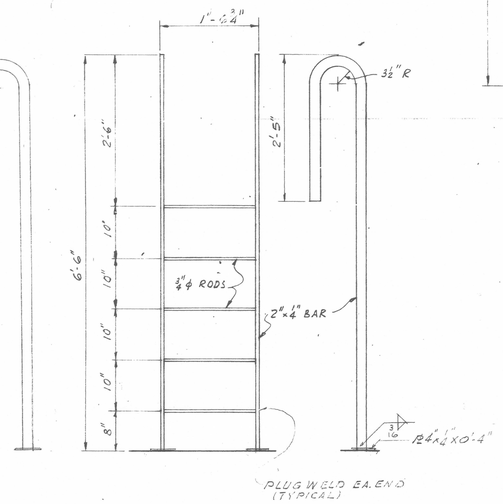

REMOV. LADDER DETAIL. 2 REQD
1" = 1'-0"

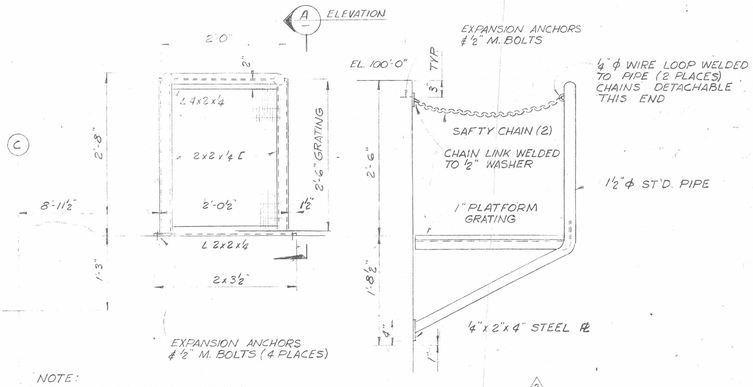

NOTE:
1) WELD GRATING TO STRUCTURE SPACE BETWEEN WELD TO BE APPROX. 4"
2) USE MINIMUM BEND RADIUS FOR PIPE BEND

ELEVATION A
SCALE: 1"=1'-0"

DETAIL 1
SCALE: 1"=1'-0" S-36

FOR CONSTRUCTION NOTES SEE DWG XI-S-32

REVISION	DATE	DESCRIPTION	AGENCY	INIT.
2	12-11-61	OPERATIONAL AS BUILT DWG - INCL. ECP 6009	BECHTEL	
1	5-12-61	CONSTRUCTION AS BUILT DRAWING	K.C.C.	

BECHTEL CORPORATION
ENGINEERS AND CONSTRUCTORS
SAN FRANCISCO — LOS ANGELES — NEW YORK

DEPARTMENT OF THE AIR FORCE
AIR FORCE BALLISTIC MISSILE DIVISION (ARDC)
INGLEWOOD, CALIFORNIA

		DATE
DESIGNED BY		
DRAWN BY	MUIRRAGUI	11-19-59
CHECKED BY	FONG	11-20-59
O.K.	M.R. Spangler	12-14-59
O.K.	S.R. OLIVER	12-14-59
APPROVED		12-14-59

WS-107 A-1 OPERATIONAL BASE
FORBES A.F.B. KANSAS
COMPLEX D, E, F, G, H, & I
LAUNCH & SERVICE BUILDING
SERVICE PLATFORM — SHT. 2

APPROVED BY FOR
BECHTEL CORP.
Maj. USAF
Chief, Operations Engineering
Captain, USAF
Project Officer
Lt. Col. USAF
AFBMD

SPECIFICATION No. ENG-23-028 - 59
DATE DEC. 4 1959 SCALE AS NOTED
DRAWING NUMBER 3115-3 XI-S-38
SHEET

WS-107A-1 ESG