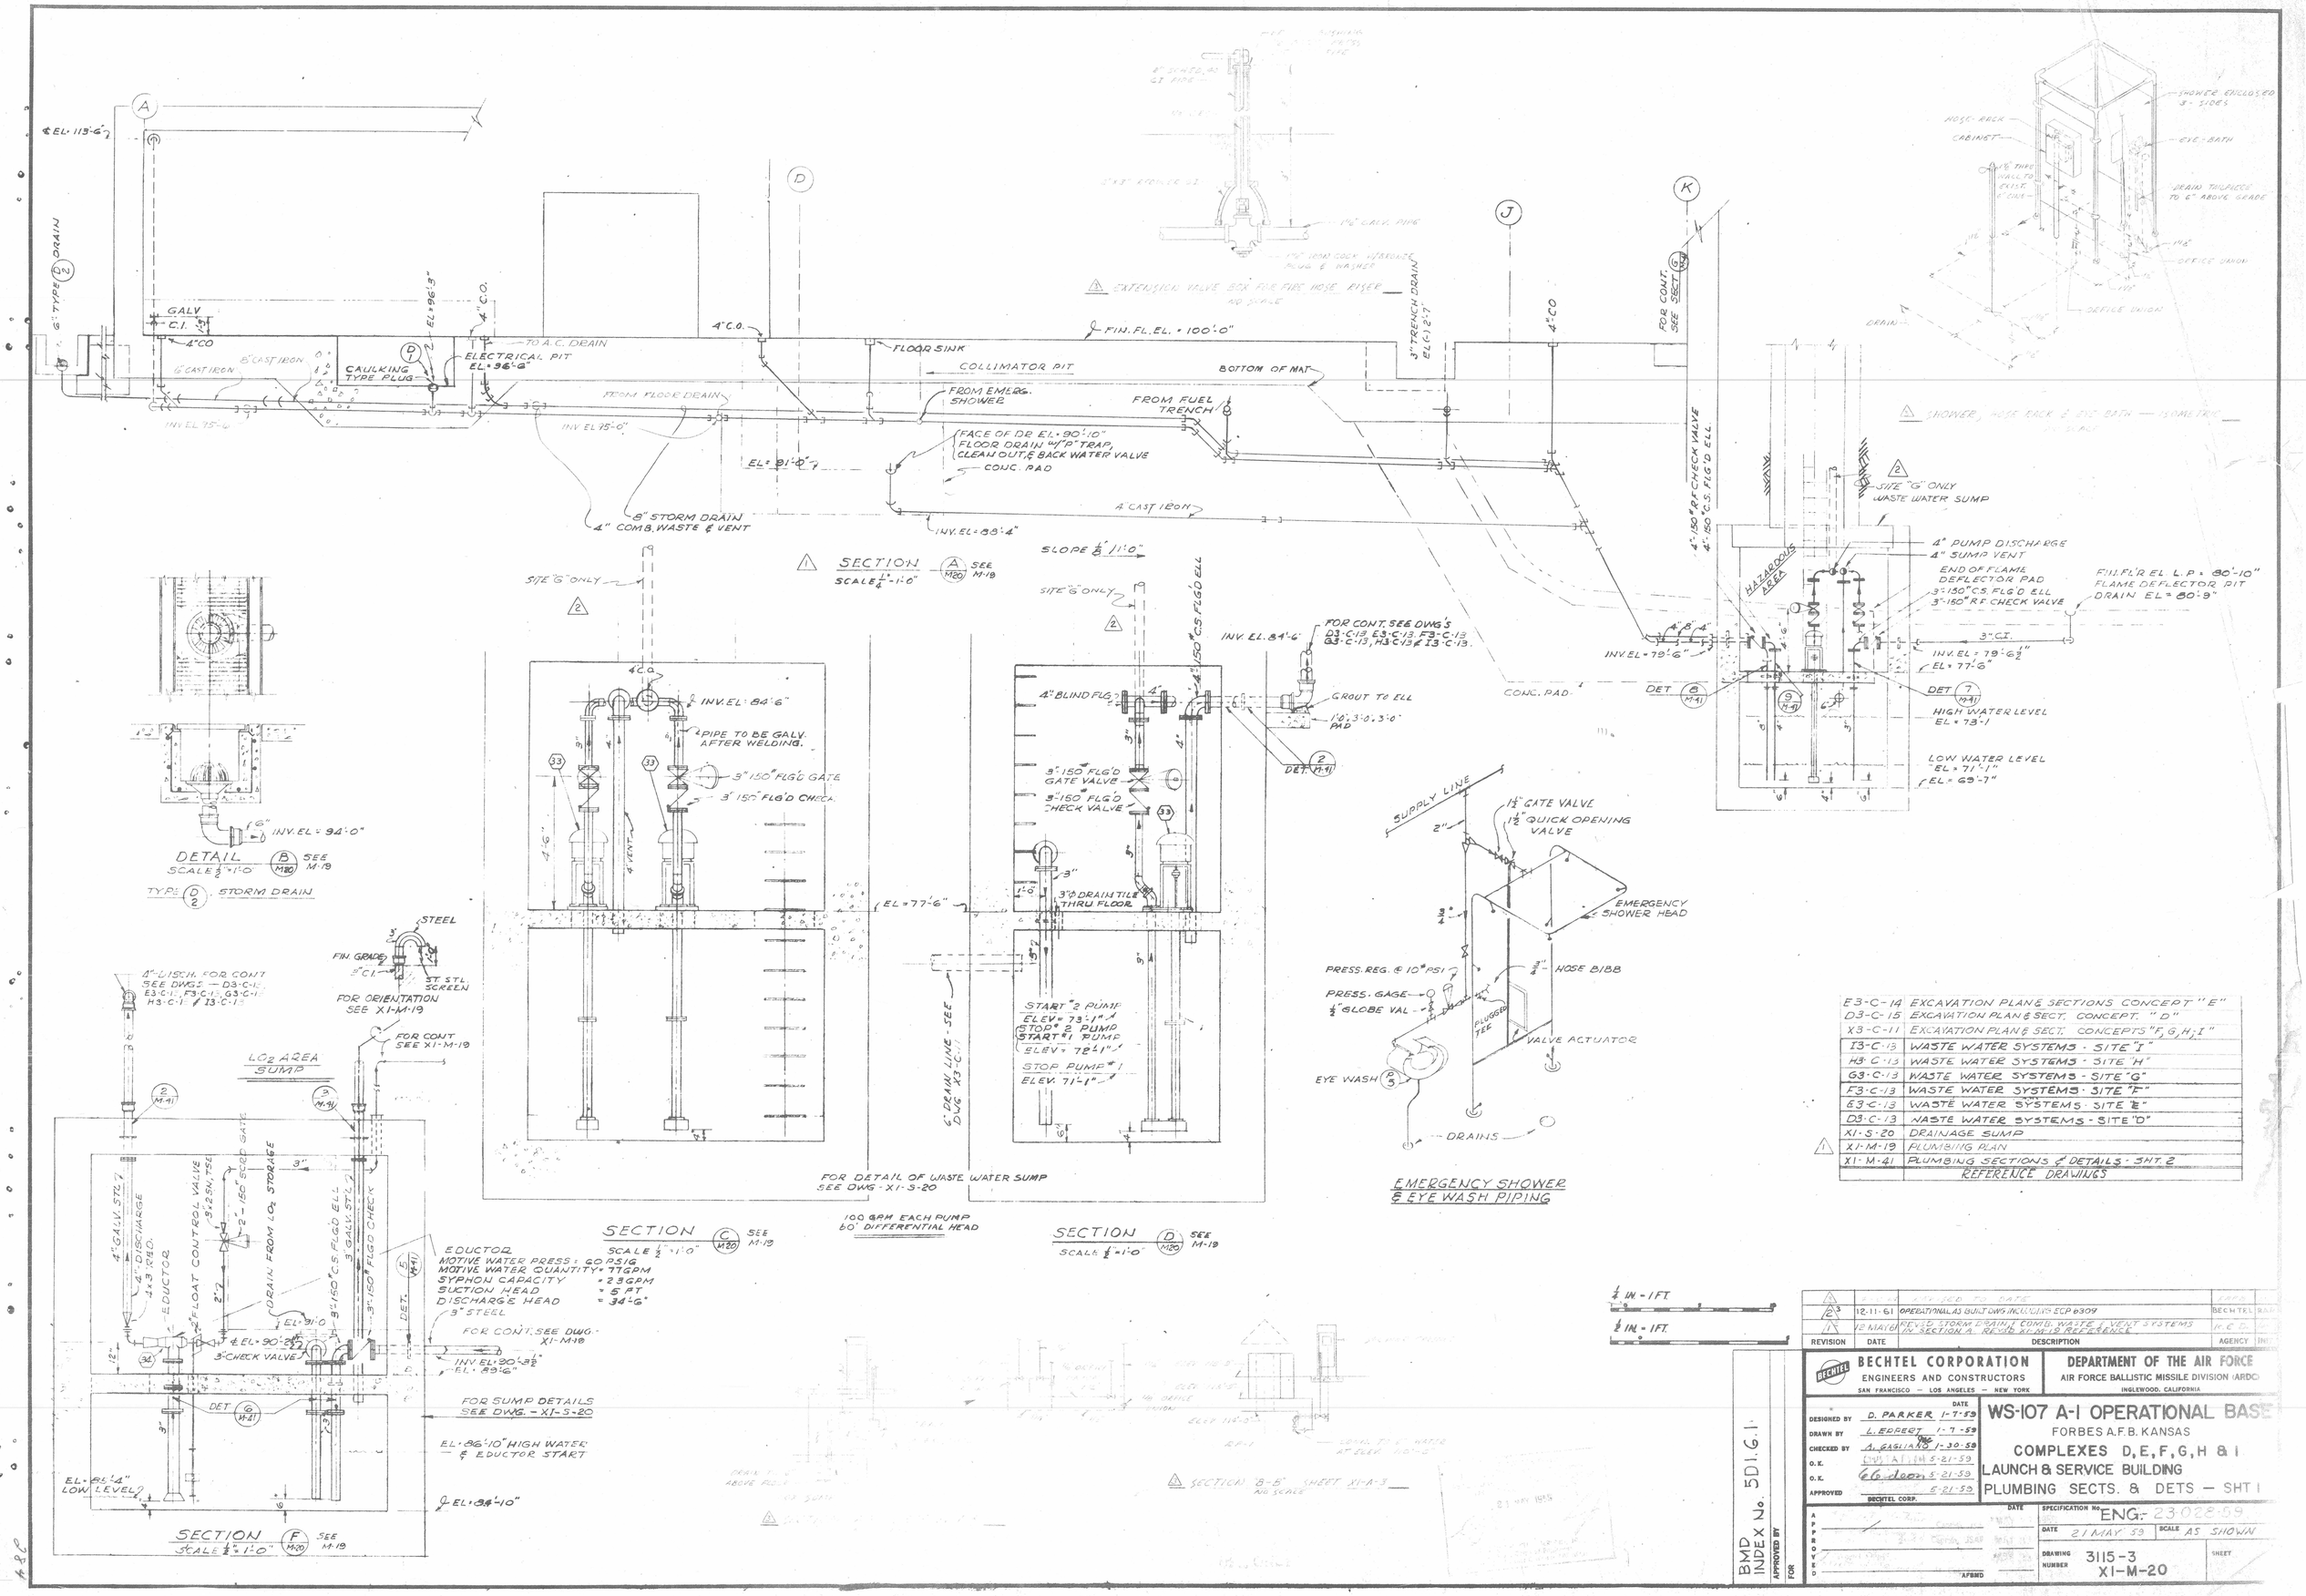

E3-C-14	EXCAVATION PLAN & SECTIONS CONCEPT "E"
D3-C-15	EXCAVATION PLAN & SECT. CONCEPT. "D"
X3-C-11	EXCAVATION PLAN & SECT. CONCEPTS "F, G, H, & I"
I3-C-13	WASTE WATER SYSTEMS - SITE "I"
H3-C-13	WASTE WATER SYSTEMS - SITE "H"
G3-C-13	WASTE WATER SYSTEMS - SITE "G"
F3-C-13	WASTE WATER SYSTEMS - SITE "F"
E3-C-13	WASTE WATER SYSTEMS - SITE "E"
D3-C-13	WASTE WATER SYSTEMS - SITE "D"
X1-S-20	DRAINAGE SUMP
X1-M-19	PLUMBING PLAN
X1-M-41	PLUMBING SECTIONS & DETAILS - SHT. 2
	REFERENCE DRAWINGS

REVISION	DATE	DESCRIPTION	AGENCY
4		AS-BUILT TO DATE	
3	12-11-61	OPERATIONAL AS BUILT DWG INCLUDING ECP 8309	BECHTEL
1	12 MAY 61	REVISED STORM DRAIN & COMB. WASTE & VENT SYSTEMS IN SECTION A. REF. DWG X1-M-19 REFERENCE	R.E.D.

BECHTEL CORPORATION
ENGINEERS AND CONSTRUCTORS
SAN FRANCISCO — LOS ANGELES — NEW YORK

DEPARTMENT OF THE AIR FORCE
AIR FORCE BALLISTIC MISSILE DIVISION (ARDC)
INGLEWOOD, CALIFORNIA

WS-107 A-1 OPERATIONAL BASE

FORBES A.F.B. KANSAS

COMPLEXES D, E, F, G, H & I

LAUNCH & SERVICE BUILDING

PLUMBING SECTS. & DETS — SHT I

		DATE
DESIGNED BY	D. PARKER	1-7-59
DRAWN BY	L. EDERER	1-7-59
CHECKED BY	A. GAGLIANO	1-30-59
O.K.		5-21-59
O.K.		5-21-59
APPROVED	BECHTEL CORP.	5-21-59

APPROVED — DATE — APBMD

SPECIFICATION No. ENG.-23-028-59

DATE 21 MAY 59 SCALE AS SHOWN

DRAWING NUMBER 3115-3 X1-M-20 SHEET

BMD INDEX No. 5D1.G.1.

APPROVED BY

FOR