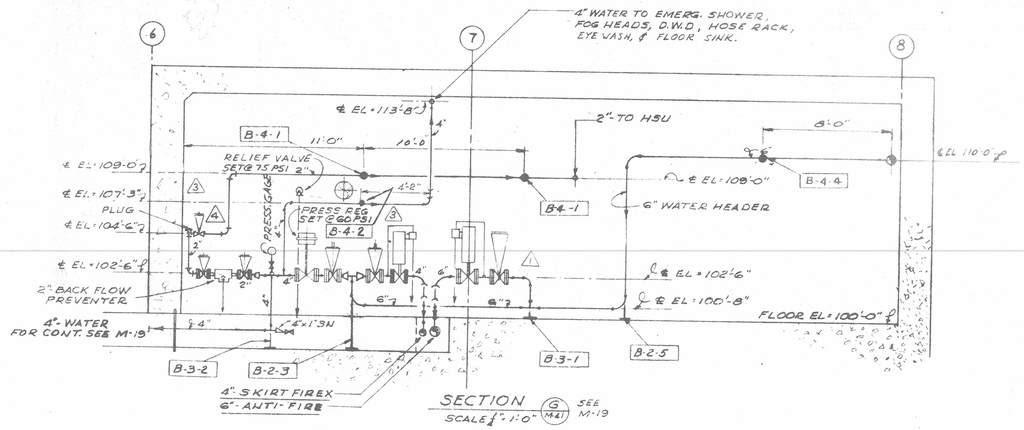

SECTION (G) M-41 SEE M-19
SCALE 1/4" = 1'-0"

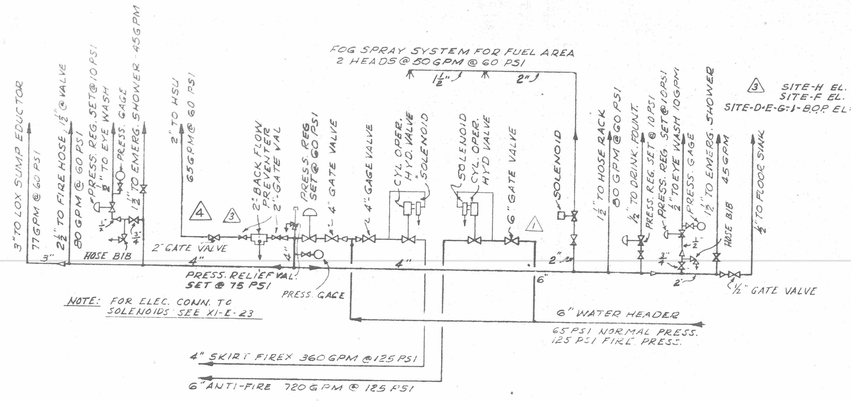

NOTE: FOR ELEC. CONN. TO SOLENOIDS SEE X1-E-23

FLOW DIAGRAM
WATER SYSTEM

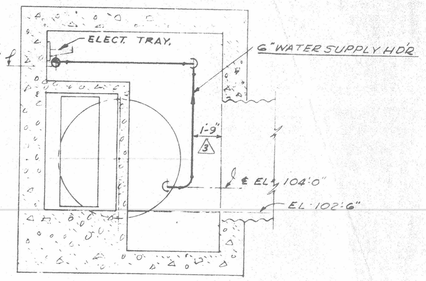

SECTION (H) M-41 SEE M-19
SCALE 1/4" = 1'-0"

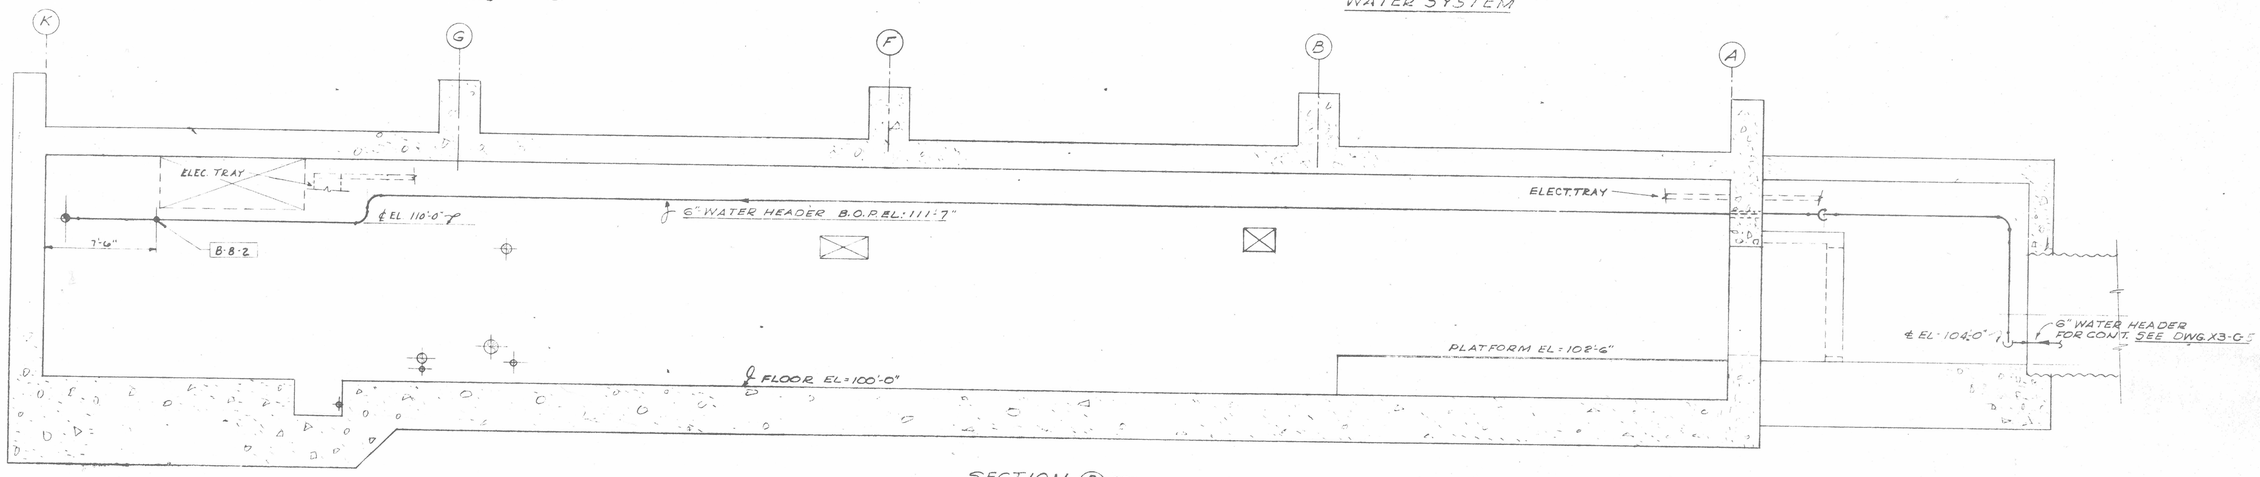

SECTION (B) M-41 SEE M-19
SCALE 1/4" = 1'-0"

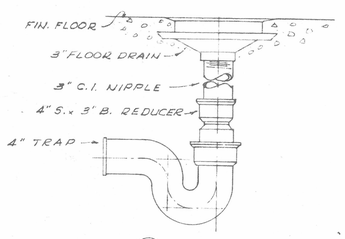

TYPE (D/1) COMB. WASTE & VENT
TYPICAL FLOOR DRAIN

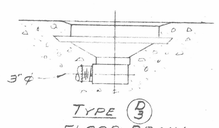

TYPE (D/3)
FLOOR DRAIN

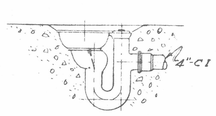

TYPE (D/5)
FLOOR DRAIN
COMB. W/ "P" TRAP, CLEAN OUT & BACK WATER VALVE

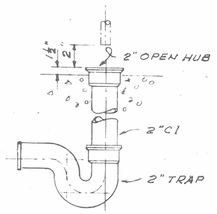

TYPE (D/6)
EQUIPMENT DRAIN

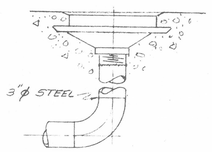

TYPE (D/4)
FLOOR DRAIN

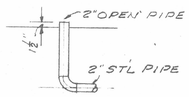

TYPE (D/7)
EYE WASH DRAIN
(LO_2 AREA ONLY)

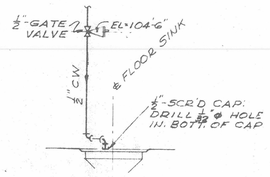

DETAIL (1) M-41 SEE M-19
NOT TO SCALE

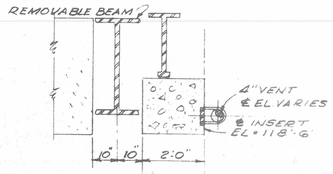

SECT. (J) M-41 SEE M-19

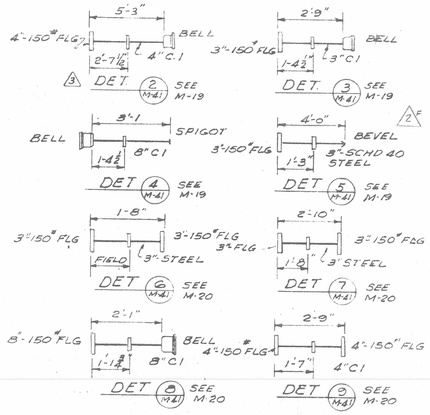

X1-M-20	PLUMBING SEC. & DET. SHT. 1
X1-M-19	PLUMBING PLAN
X3-C-5	UTILITY TUNNEL - TYPICAL SECTIONS & DETAILS
	REFERENCE DRAWINGS

△F ... DENOTES CHANGE ACCOMPLISHED BY FIELD

REVISION NOTE △2
DELETED 3/16" LINE TO COND. REC. & PLUG
REV'D ELEV. & DIM. IN SEC. H
RELOCATED SUPPORT B-4-2
DIM. CHG. - DET. 2

1/4 IN. = 1 FT

REVISION	DATE	DESCRIPTION	AGENCY	INIT.
△2	12-11-61	OPERATIONAL AS BUILT DWG. INCLUDES ECP 6106	BECHTEL	[illegible]
△3	12 MAY 61	CONSTRUCTION AS BUILT DWG. - SEE REVISION NOTE-3	K.C.D.	[illegible]
△4	[illegible]	DETAIL [illegible] CHANGED FROM 2'-0" TO 4'-0" AS PER CO-POINT	BECHTEL	[illegible]
△5	3 SEPT. 59	DELETED 2"x3" RELIEF VALVE AT SECTION G & FLOW DIAG.	BECHTEL	[illegible]

BECHTEL CORPORATION
ENGINEERS AND CONSTRUCTORS
SAN FRANCISCO — LOS ANGELES — NEW YORK

DEPARTMENT OF THE AIR FORCE
AIR FORCE BALLISTIC MISSILE DIVISION (ARDC)
INGLEWOOD, CALIFORNIA

		DATE
DESIGNED BY	D. PARKER	1-7-59
DRAWN BY	L.C. EDDERT	3-2-59
CHECKED BY	A.R. SIMMONS	3-3-59
O.K.	GUSTAFSON	5-21-59
O.K.	G. Gideon	5-21-59
APPROVED		5-21-59
	BECHTEL CORP.	

WS-107 A-1 OPERATIONAL BASE
FORBES A.F.B. KANSAS
COMPLEXES D, E, F, G, H & I
LAUNCH & SERVICE BUILDING
PLUMBING SECTS. & DETS - SHT 2

APPROVED BY / FOR — DATE
Colonel, USAF, Chief, Engineering Division — MAY 1959
Colonel, USAF, Chief, Project Office — MAY 1959
Lt. Col., USAF, AFBMD — MAY 1959

SPECIFICATION No. ENG-23-028-59
DATE 21 MAY 59 SCALE 1/4" = 1'-0"
DRAWING NUMBER 3115-3 XI-M-41
SHEET

BMD INDEX No. 5D1.6.1

21 MAY 1959
CHIEF, ENGINEERING DIVISION
Air Force Ballistic Missile Div. (ARDC)

FOR OFFICIAL USE ONLY