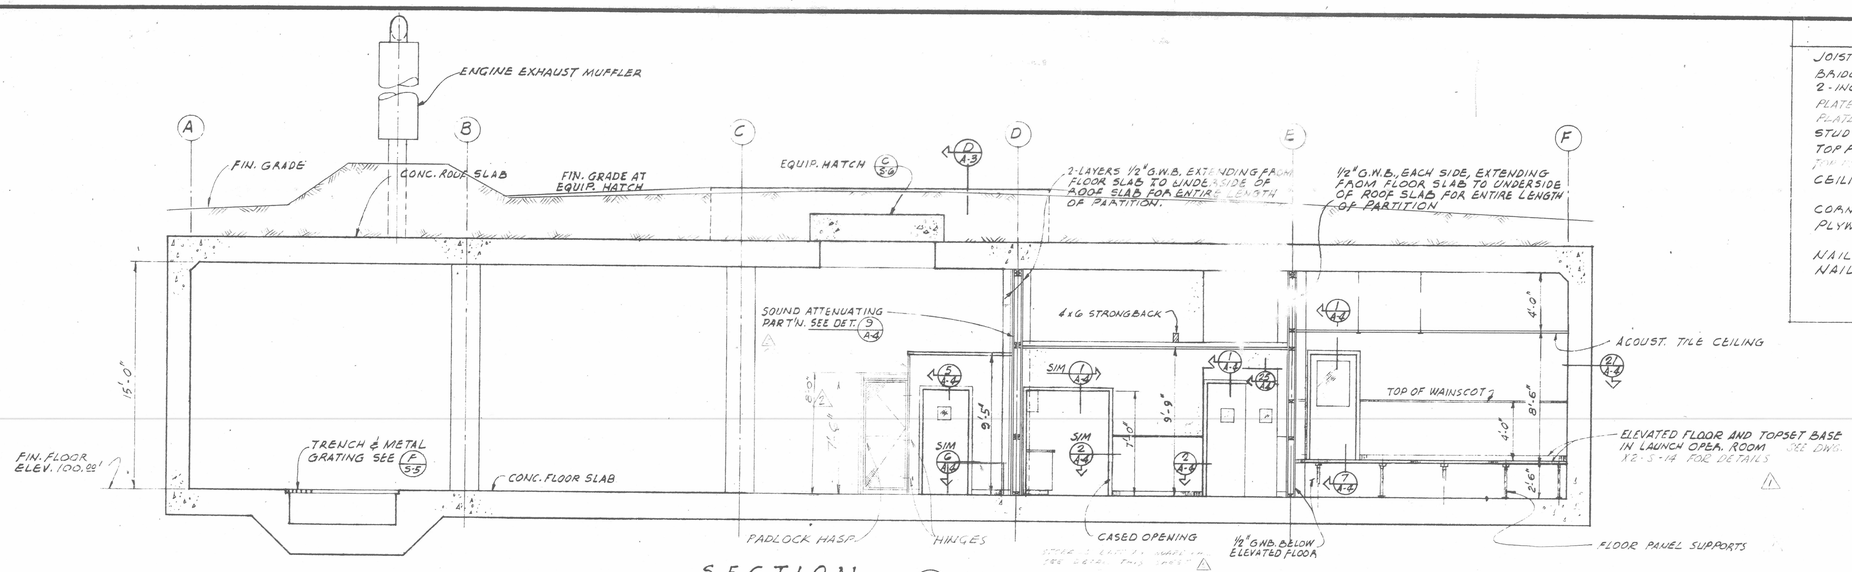

SECTION (A/A-3) A-1
SCALE 1/4" = 1'-0"

NAILING SCHEDULE

JOIST TO SILL - TOE NAIL	2-16d
BRIDGING TO JOIST - TOE NAIL	2-8d
2-INCH SUBFLOOR TO JOIST	2-16d
PLATE TO JOIST OR BLOCKING - TOE NAIL	16d @ 16" O.C.
PLATE TO STUD - END NAIL	2-16d
STUD TO PLATE - TOE NAIL	3-16d OR 4-8d
TOP PLATE - SPIKE TOGETHER	16d - 24" O.C.
TOP PLATE - LAPS AND INTERSECTIONS	2-16d
CEILING JOIST - TO PLATE - TOE NAIL	2-16d
LAPS OVER PARTITIONS	3-16d
CORNER STUDS AND ANGLES	16d - 30" O.C.
PLYWOOD SUBFLOOR TO JOIST	8d - 6" O.C.

NAIL SIZES SHOWN ARE FOR BOX OR COMMON NAILS.

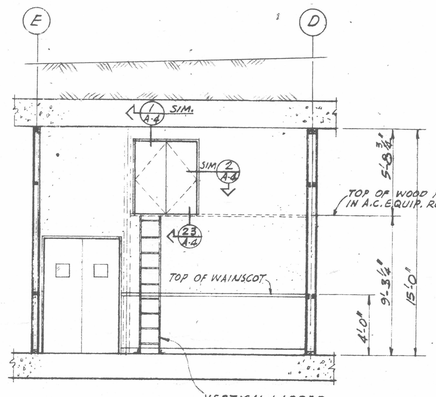

SECTION (C/A-3) A-2

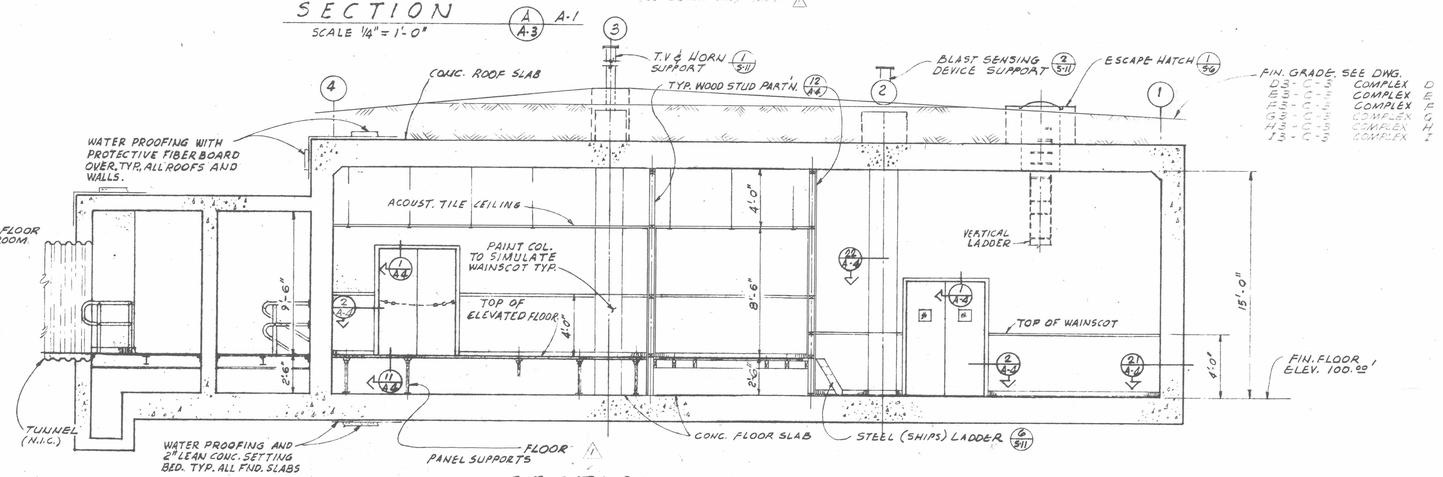

SECTION (B/A-3) A-1
SCALE 1/4" = 1'-0"

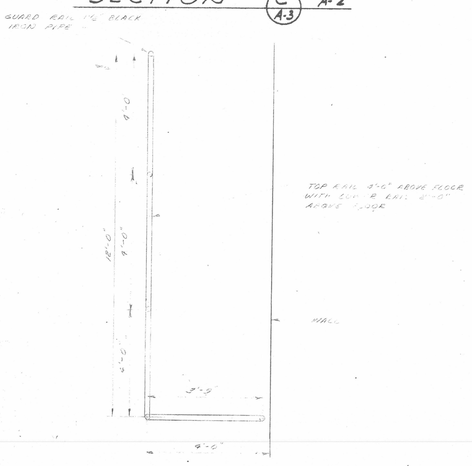

PLAN OF STORAGE BATTERY
GUARD RAIL
SCALE 1/2" = 1'-0"

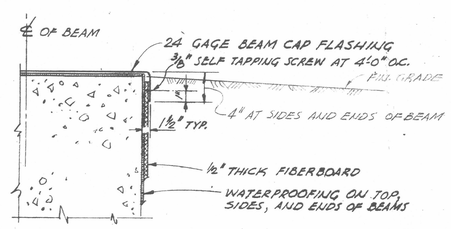

SECTION (D/A-3) A-3
SCALE: 1½" = 1'-0"

1½ IN = 1 FT.

¼ IN = 1 FT.

REVISION	DATE	DESCRIPTION	AGENCY	INIT.
7	1-2-64	REVISED TO DATE	FAFB	
6	12-11-61	OPERATIONAL AS BUILT DRAWING	BECHTEL	
5	5-12-61	CONSTRUCTION AS BUILT DRAWING	K.C.D.	
4	6-24-60	REMOVED MESH PARTITION & RELOCATED GATE DUE TO C.O. FOR '73	BECHTEL	CMC
3	1-6-60	REMOVED (N.I.C.) SECT. A & B & ADDED NOTE - "SEE DWG X2-3-14"	BECHTEL	CSM

BECHTEL CORPORATION
ENGINEERS AND CONSTRUCTORS
SAN FRANCISCO — LOS ANGELES — NEW YORK

DEPARTMENT OF THE AIR FORCE
AIR FORCE BALLISTIC MISSILE DIVISION (ARDC)
INGLEWOOD, CALIFORNIA

		DATE
DESIGNED BY	B.C.P.	4/6/59
DRAWN BY	G.L.	4/6/59
CHECKED BY	R.C.P.	5/7/59
O.K.	[illegible]	5-21-59
O.K.	[illegible]	5-21-59
APPROVED	BECHTEL CORP.	5-21-59

WS-107 A-I OPERATIONAL BASE
FORBES A. F. B. KANSAS
COMPLEXES D, E, F, G, H & I
LAUNCH OPERATIONS BUILDING
SECTIONS

SPECIFICATION No. ENG-23-028-59
DATE 21 MAY 59
SCALE 1/4" = 1'-0" UNLESS NOTED
DRAWING NUMBER 3115-3 X2-A-3
SHEET

APPROVED FOR AFBMD — DATE

BMD INDEX No. 5D1.G.1
APPROVED BY

CLEARED FOR OPEN PUBLICATION
U.S. AIR FORCE, LOS ANGELES AIR FORCE STATION
REVIEW OF CONSTRUCTION FEASIBILITY
FOR THE CORPS OF ENGINEERS
21 APR 1959
CLIFTON H. CHAMBERLAIN, JR.
Lt. Col., U.S. Air Force
Assistant District Engineer (AFMPD)