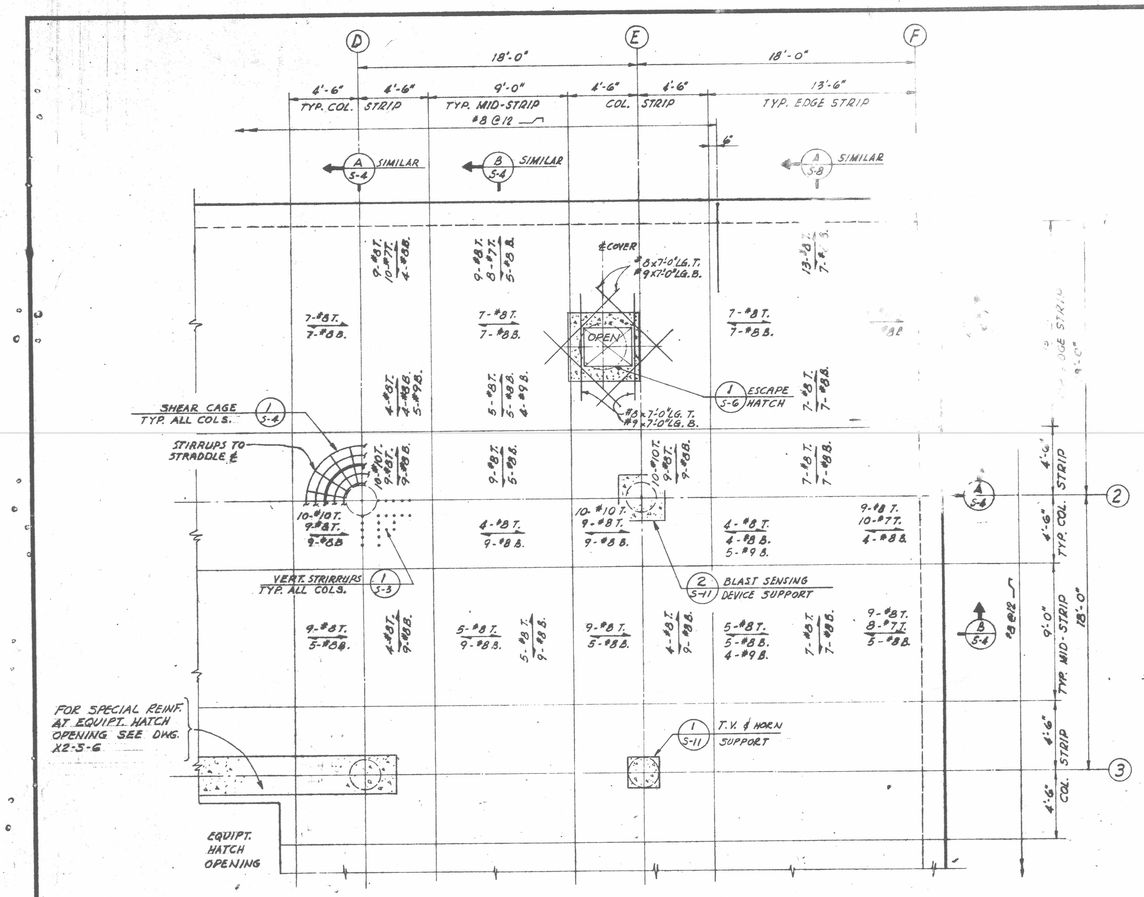

ROOF SLAB REINFORCING PLAN

1/4" = 1'-0"

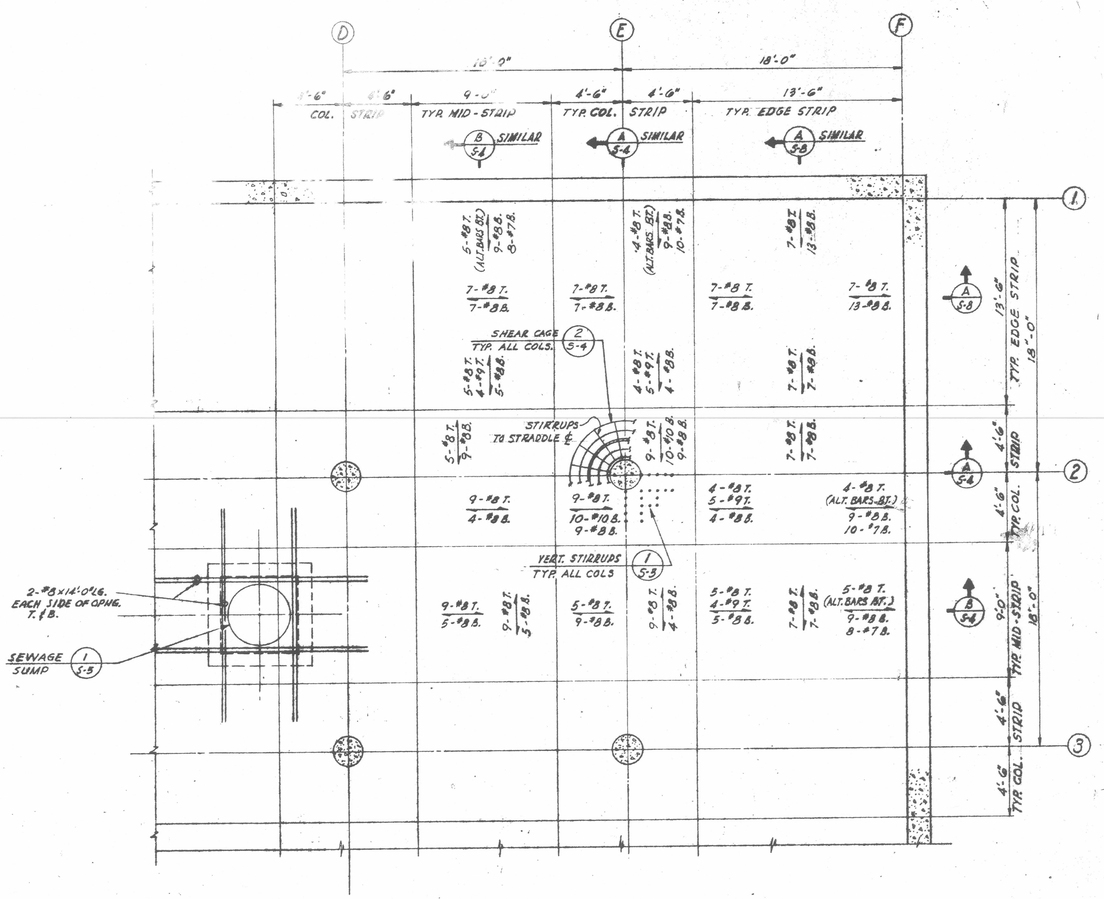

FOUNDATION SLAB REINFORCING PLAN

1/4" = 1'-0"

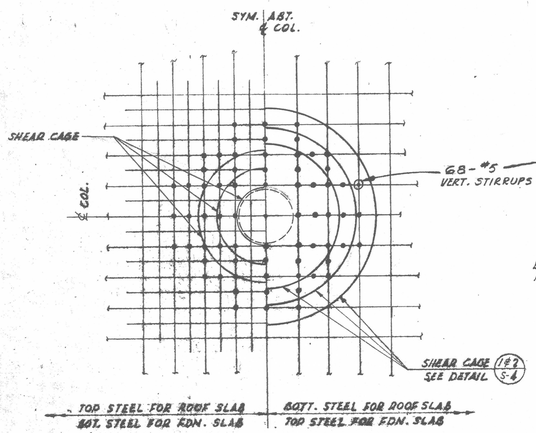

DETAIL 1/S-3 SEE S-4

1/2" = 1'-0"

PLAN-TYP. VERTICAL STIRRUPS AT ALL COLS.

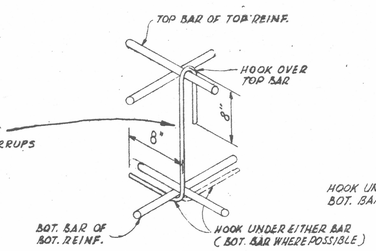

ORIENTATION FOR ROOF SLAB

NO SCALE

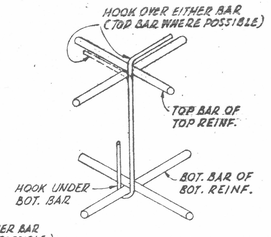

ORIENTATION FOR FDN. SLAB

NO SCALE

1/4 IN. = 1 FT.

1/2 IN. = 1 FT.

REVISION	DATE	DESCRIPTION	AGENCY	INIT.
2	12-11-61	OPERATIONAL AS-BUILT DRAWING	BECHTEL	SE
1	5-12-61	CONSTRUCTION AS BUILT DRAWING	R.C.D.	[illegible]

BECHTEL CORPORATION
ENGINEERS AND CONSTRUCTORS
SAN FRANCISCO — LOS ANGELES — NEW YORK

DEPARTMENT OF THE AIR FORCE
AIR FORCE BALLISTIC MISSILE DIVISION (ARDC)
INGLEWOOD, CALIFORNIA

		DATE
DESIGNED BY	AMM HDY	4-2-59
DRAWN BY	[illegible] GCN	4-4-59
CHECKED BY	CSW	5-21-59
O.E.	WM Hetaylor	5-21-59
O.E.	[illegible]	5-21-59
APPROVED	BECHTEL CORP.	5-21-59

WS 107 A-1 OPERATIONAL BASE
FORBES A.F.B. KANSAS
COMPLEXES D, E, F, G, H & I
LAUNCH OPERATIONS BUILDING
REINFORCING PLANS

SPECIFICATION No. ENG-23-028-59-
DATE MAY 21, 1959
SCALE 1/4" & 1/2" = 1'-0"
DRAWING NUMBER 3115-3 X2-S-3
SHEET

BMD INDEX No. 5D1.6.1

APPROVED BY
FOR

CHIEF, MISSILE OFFICE
U.S. Army Engr. Div. Los Angeles
REVIEWED FOR CONSTRUCTION, FEASIBILITY FOR THE CONSTRUCTION ENGINEERS
21 MAY 1959
CLIFTON H. CHAMBERLAIN, JR.
Lt. Col., Corps of Engineers
Assistant District Engineer (AFMPO)