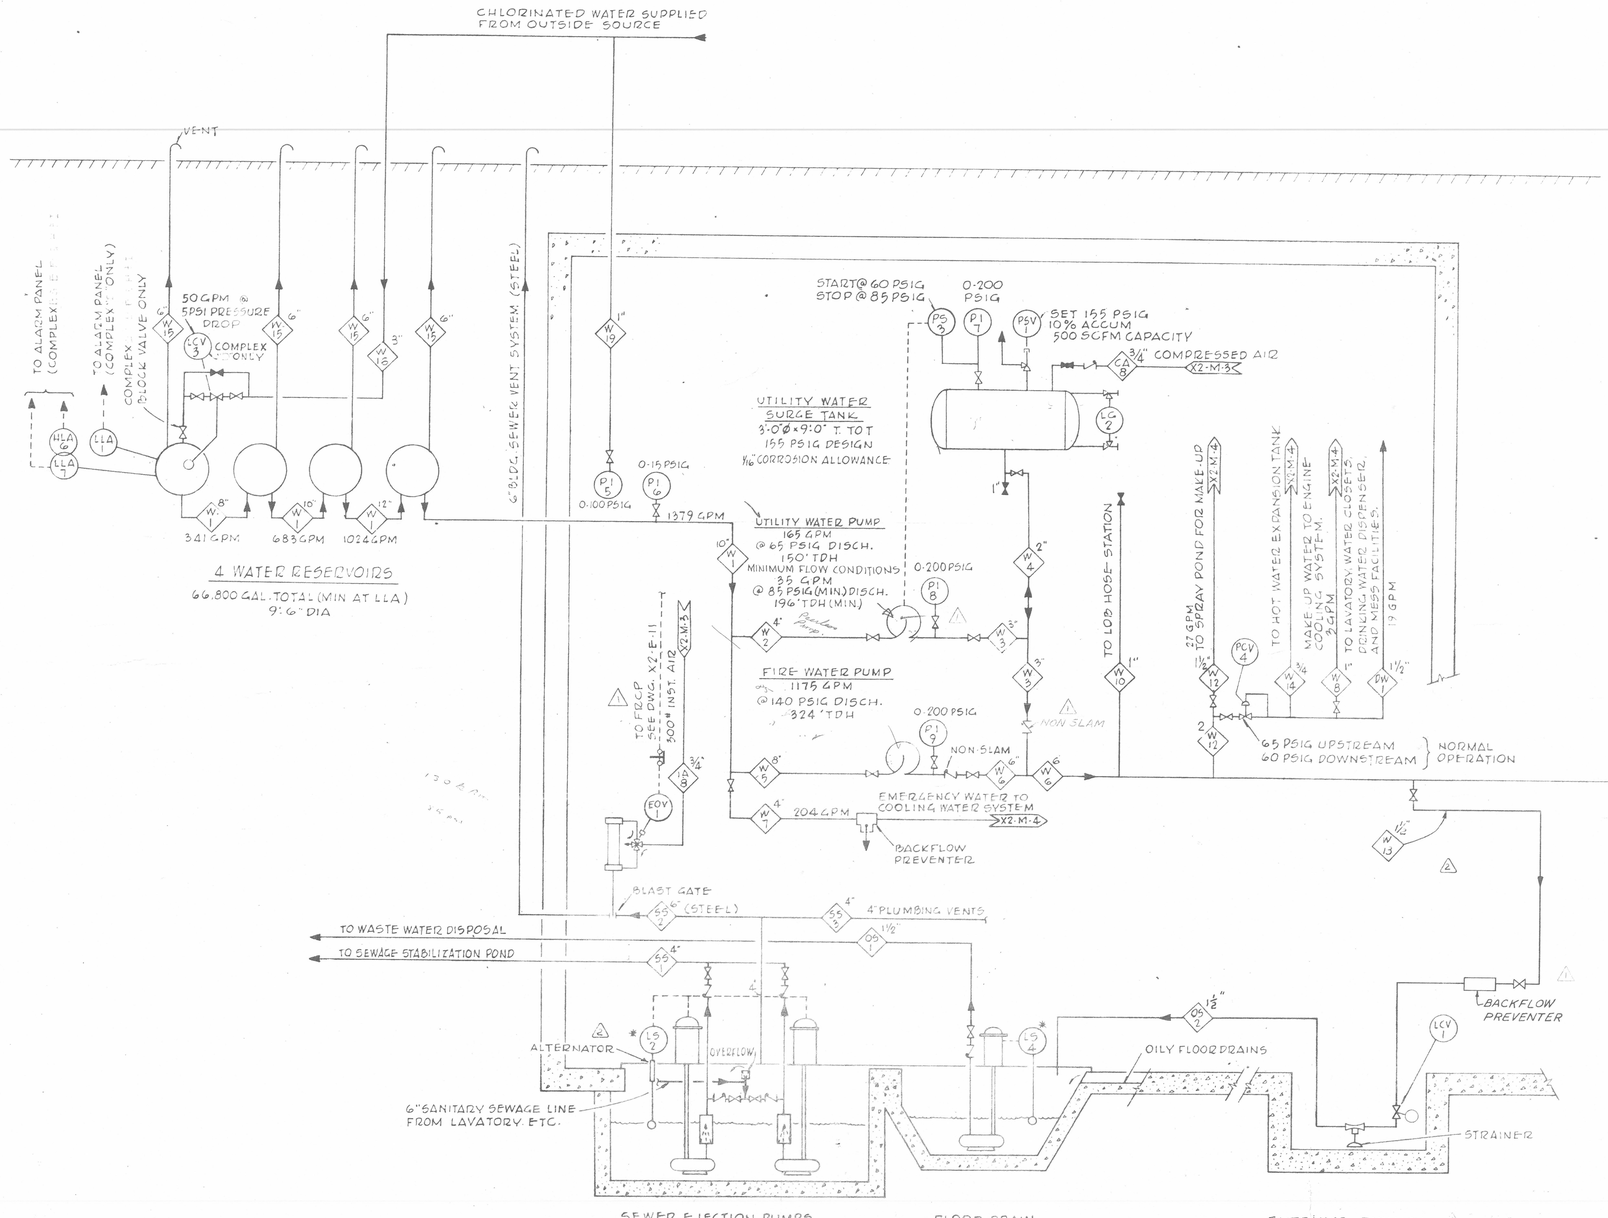

NOTES

1. FOR LEGEND & SYMBOLS SEE X2-M-1
2. * TO BE MANUFACTURER'S STANDARD SUITABLE FOR THE SERVICE. SIZE AND RATING SHALL BE SUITABLE FOR THE EQUIPMENT FURNISHED.
3. PIPELINE WATER QUANTITIES ARE FOR INFORMATION ONLY

REVISION	DATE	DESCRIPTION	AGENT
2	12-11-61	OPERATIONAL AS BUILT DWG	BECHTEL
1	12 MAY 61	CONSTRUCTION AS BUILT DWG. - RELOCATED ALTERNATOR AT LS-2, DELETED LS-3, & REROUTED LINE # W-13	

BECHTEL CORPORATION
ENGINEERS AND CONSTRUCTORS
SAN FRANCISCO — LOS ANGELES — NEW YORK

DEPARTMENT OF THE AIR FORCE
AIR FORCE BALLISTIC MISSILE DIVISION
INGLEWOOD, CALIFORNIA

	DATE
DESIGNED BY	
DRAWN BY	4-5-61
CHECKED BY	
O.E.	
O.E.	
APPROVED BECHTEL CORP.	

WS 107 A[illegible] OPERATIONAL BA[illegible]
[illegible]S AFB, KANSAS
COMPLEXES D, E, F, G, H & I
LAUNCH OPERATIONS BUILDI[illegible]
FLOW DIAGRAM - WATER & S[illegible]

	DATE
APPROVED	
APPROVED	
APPROVED	
APPROVED	
AMEND	

SPECIFICATION No. ENG.23-028-59
DATE JANUARY 59 SCALE NONE
DRAWING NUMBER 3115-3 X2-M-2

B.M.D. INDEX NO.
APPROVED BY
FOR