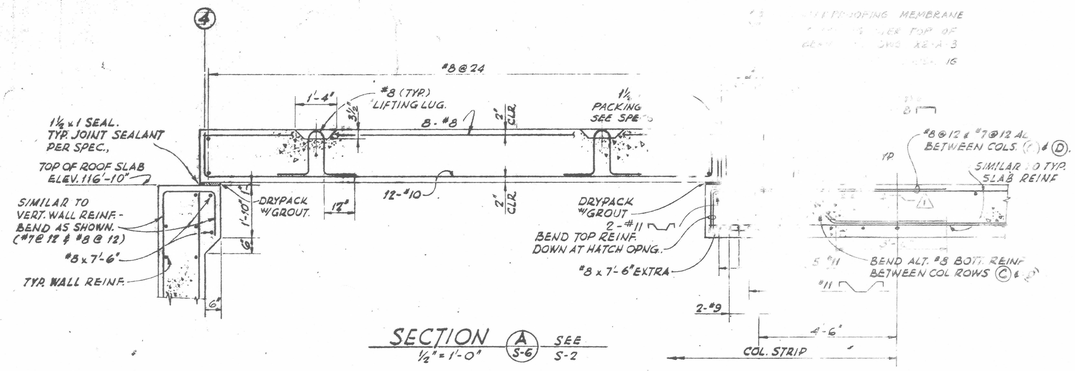

SECTION (A) S-6 SEE S-2
½" = 1'-0"

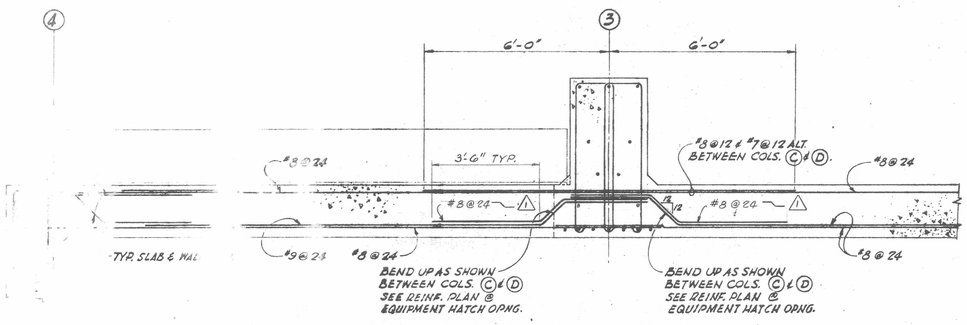

SECTION (E) S-6 SEE S-2
½" = 1'-0"

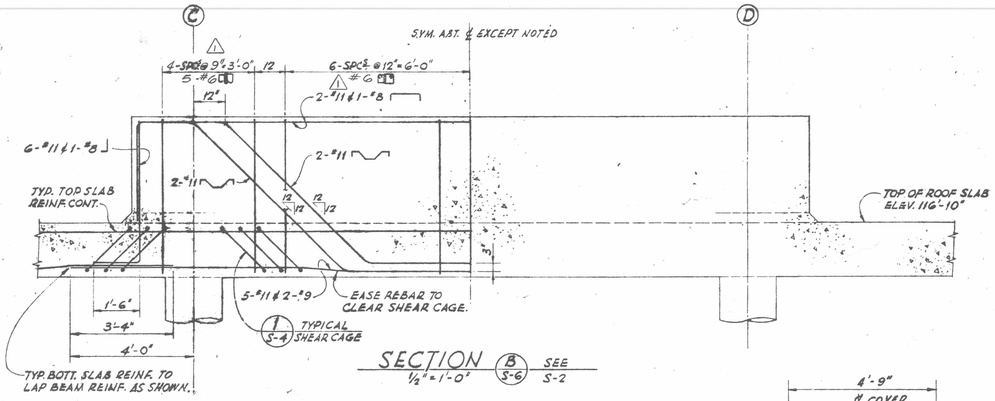

SECTION (B) S-6 SEE S-2
½" = 1'-0"

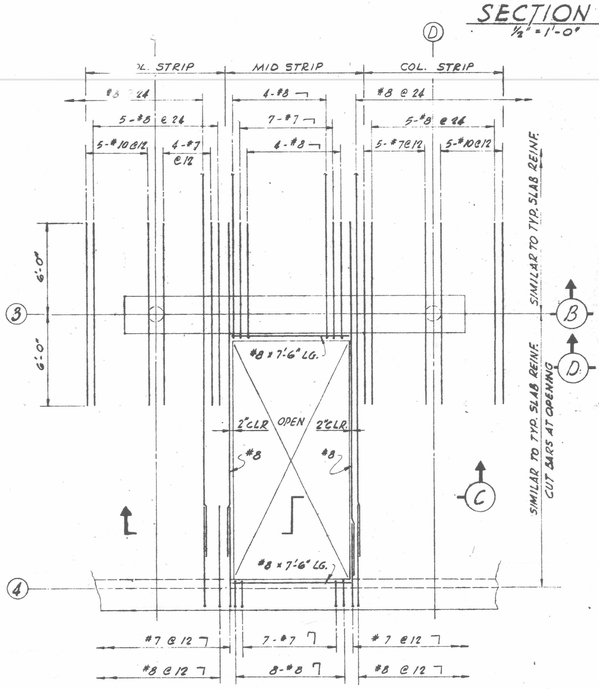

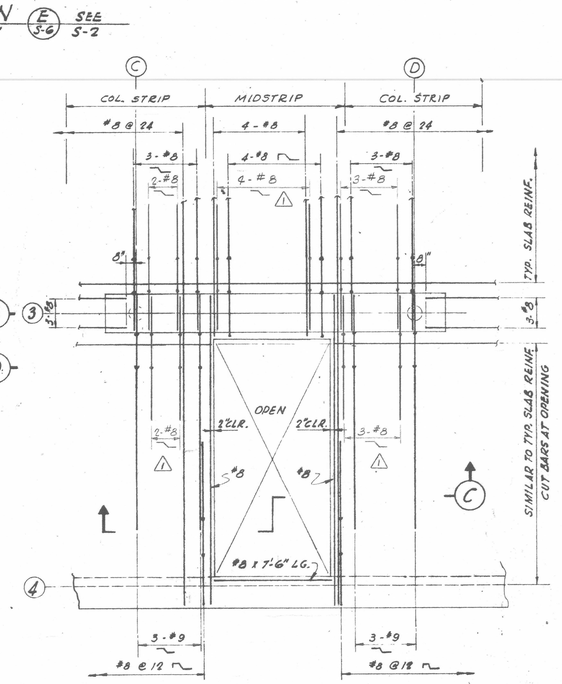

PLAN - SPECIAL REINF. AT EQUIPMENT HATCH OPENING
¼" = 1'-0"

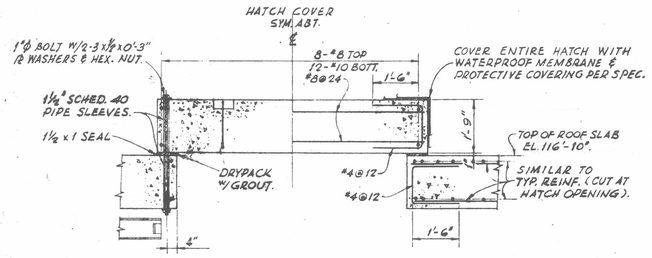

SECTION (C) S-6 SEE S-2
½" = 1'-0"

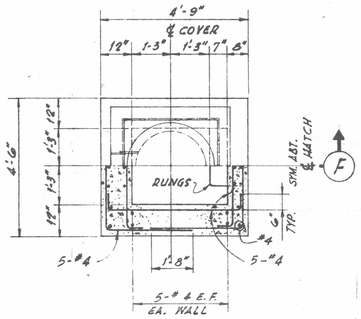

DETAIL (1) S-6 SEE S-2
PLAN - ESCAPE HATCH

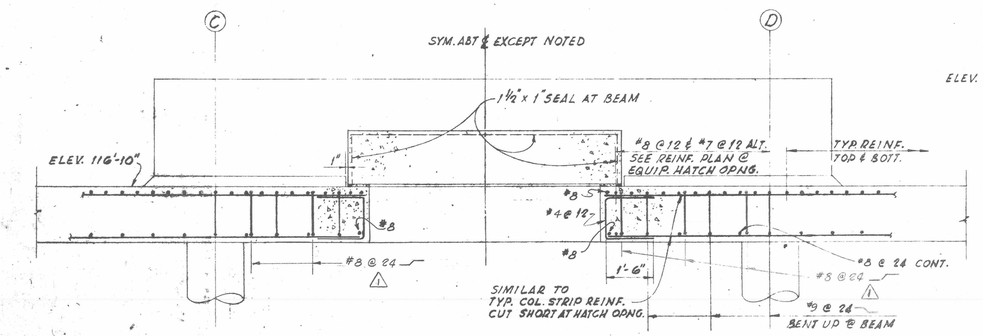

SECTION (D) S-6 SEE S-2
½" = 1'-0"

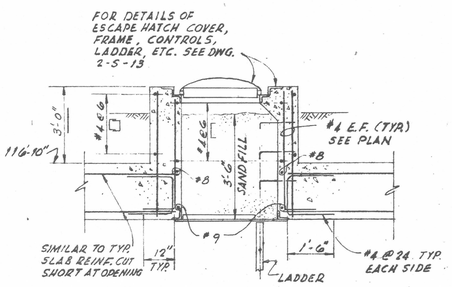

SECTION (F)
½" = 1'-0"

½ IN = 1 FT.

½ IN = 1 FT.

CAC
Corps of Engineers
U.S. Army Engr. District, Los Angeles
REVISED AS SHOWN ON PRINTS DATED 23 MAY 1959
FOR THE CHIEF OF ENGINEERS
23 MAY 1959
CLIFTON N. CHAMBERLAIN, JR.
Lt. Col., Corps of Engineers
Assistant District Engineer (AFBMD)

REVISION	DATE	DESCRIPTION	AGENCY	INIT.
3	12-11-61	OPERATIONAL AS BUILT DRAWING	AFBMD	
2	5-12-61	CONSTRUCTION AS BUILT DRAWING	M.C.C.	
1 IO	9 SEPT 59	REVISED STIRRUPS IN SECT. B, ADDED REINFORCING IN SECT'S. A, D, E & AT EQUIP. HATCH OPENING.	BECHTEL	

BECHTEL CORPORATION
ENGINEERS AND CONTRACTORS
SAN FRANCISCO — LOS ANGELES — NEW YORK

DEPARTMENT OF THE AIR FORCE
AIR FORCE BALLISTIC MISSILE DIVISION (ARDC)
INGLEWOOD, CALIFORNIA

	DATE
DESIGNED BY	AMM HDY 4-1-59
DRAWN BY	R.F.Z GCN 4-1-59
CHECKED BY	GMW 5-21-59
O.K.	LMcTaylor 5-21-59
O.K.	GAWilson 5-21-59
APPROVED	BECHTEL CORP. 5-21-59

WS-107 A-I OPERATIONAL BASE
FORBES A. F. B., KANSAS
COMPLEXES D, E, F, G, H & I
LAUNCH OPERATIONS BUILDING
ROOF SECTIONS & DETAILS

APPROVED FOR AFBMD — DATE

SPECIFICATION No. ENG-23-028-59-
DATE MAY 21, 1959
SCALE 1/8" & 1/2" = 1'-0"
DRAWING NUMBER 3115-3 X2-S-6
SHEET

BMD INDEX No. 5D1.6.1
APPROVED BY
FOR