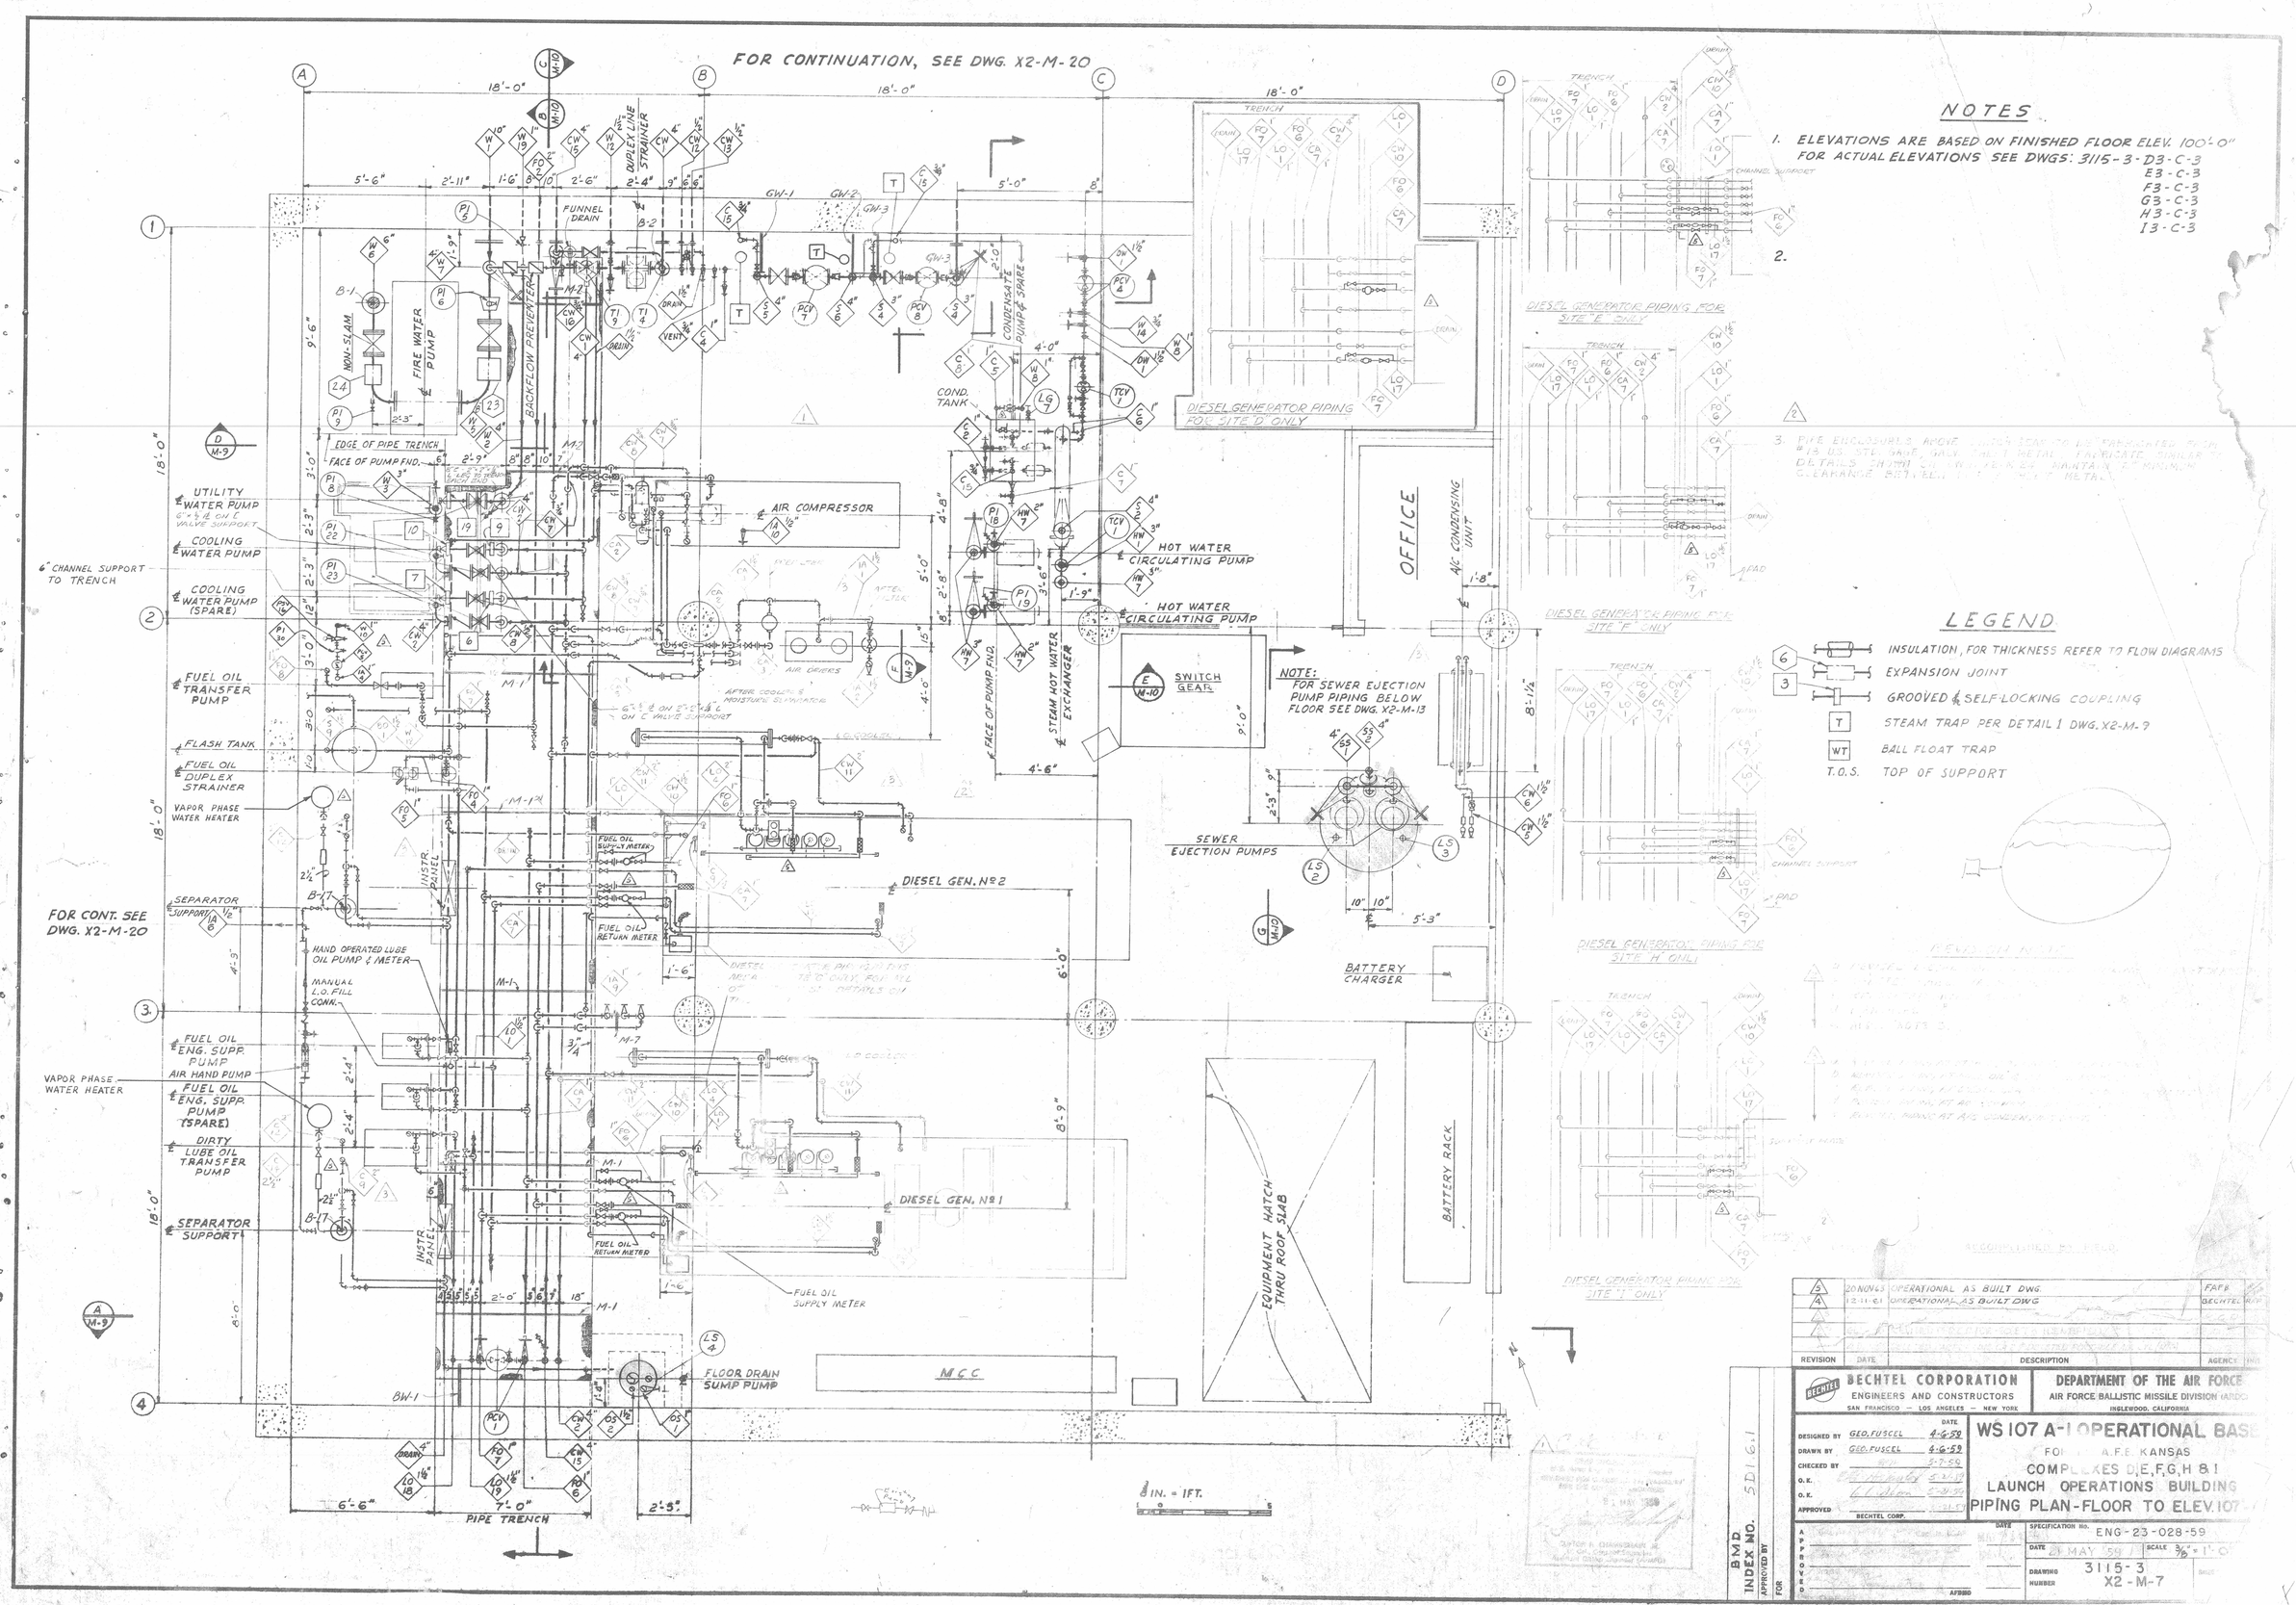
FOR CONTINUATION, SEE DWG. X2-M-20
FOR CONT. SEE DWG. X2-M-20
NOTES
1. ELEVATIONS ARE BASED ON FINISHED FLOOR ELEV. 100'-0" FOR ACTUAL ELEVATIONS SEE DWGS: 3115-3-D3-C-3 E3-C-3 F3-C-3 G3-C-3 H3-C-3 I3-C-3
2.
LEGEND
INSULATION, FOR THICKNESS REFER TO FLOW DIAGRAMS
EXPANSION JOINT
GROOVED & SELF-LOCKING COUPLING
STEAM TRAP PER DETAIL 1 DWG. X2-M-9
BALL FLOAT TRAP
T.O.S. TOP OF SUPPORT
NOTE: FOR SEWER EJECTION PUMP PIPING BELOW FLOOR SEE DWG. X2-M-13
OFFICE
A/C CONDENSING UNIT
DIESEL GENERATOR PIPING FOR SITE "D" ONLY
DIESEL GENERATOR PIPING FOR SITE "E" ONLY
DIESEL GENERATOR PIPING FOR SITE "F" ONLY
DIESEL GENERATOR PIPING FOR SITE "H" ONLY
DIESEL GENERATOR PIPING FOR SITE "I" ONLY
FIRE WATER PUMP
BACKFLOW PREVENTER
NON-SLAM
DUPLEX LINE STRAINER
FUNNEL DRAIN
EDGE OF PIPE TRENCH
FACE OF PUMP FND.
UTILITY WATER PUMP
COOLING WATER PUMP
COOLING WATER PUMP (SPARE)
6" CHANNEL SUPPORT TO TRENCH
AIR COMPRESSOR
FUEL OIL TRANSFER PUMP
FLASH TANK
FUEL OIL DUPLEX STRAINER
VAPOR PHASE WATER HEATER
SEPARATOR SUPPORT
HAND OPERATED LUBE OIL PUMP & METER
MANUAL L.O. FILL CONN.
FUEL OIL ENG. SUPP. PUMP
AIR HAND PUMP
FUEL OIL ENG. SUPP. PUMP (SPARE)
DIRTY LUBE OIL TRANSFER PUMP
INSTR. PANEL
DIESEL GEN. No 2
DIESEL GEN. No 1
FUEL OIL RETURN METER
FUEL OIL SUPPLY METER
COND. TANK
CONDENSATE PUMP & SPARE
HOT WATER CIRCULATING PUMP
STEAM HOT WATER EXCHANGER
SWITCH GEAR
SEWER EJECTION PUMPS
BATTERY CHARGER
BATTERY RACK
EQUIPMENT HATCH THRU ROOF SLAB
MCC
FLOOR DRAIN SUMP PUMP
PIPE TRENCH
1/8 IN. = 1FT.
REVISION
DATE
DESCRIPTION
AGENCY
5 20 NOV 63 OPERATIONAL AS BUILT DWG.
4 12-11-61 OPERATIONAL AS BUILT DWG
BECHTEL CORPORATION
ENGINEERS AND CONSTRUCTORS
SAN FRANCISCO — LOS ANGELES — NEW YORK
DEPARTMENT OF THE AIR FORCE
AIR FORCE BALLISTIC MISSILE DIVISION (ARDC)
INGLEWOOD, CALIFORNIA
DESIGNED BY GEO. FUSCEL 4-6-59
DRAWN BY GEO. FUSCEL 4-6-59
CHECKED BY 5-7-59
O.K. 5-21-59
O.K. 5-21-59
APPROVED BECHTEL CORP.
WS 107 A-1 OPERATIONAL BASE
FOR A.F.B. KANSAS
COMPLEXES D, E, F, G, H & I
LAUNCH OPERATIONS BUILDING
PIPING PLAN-FLOOR TO ELEV. 107'-11"
SPECIFICATION No. ENG-23-028-59
DATE 21 MAY '59
SCALE 3/8" = 1'-0"
DRAWING NUMBER 3115-3 X2-M-7
BMD INDEX NO. 5D1.6.1
APPROVED FOR
AFBMD