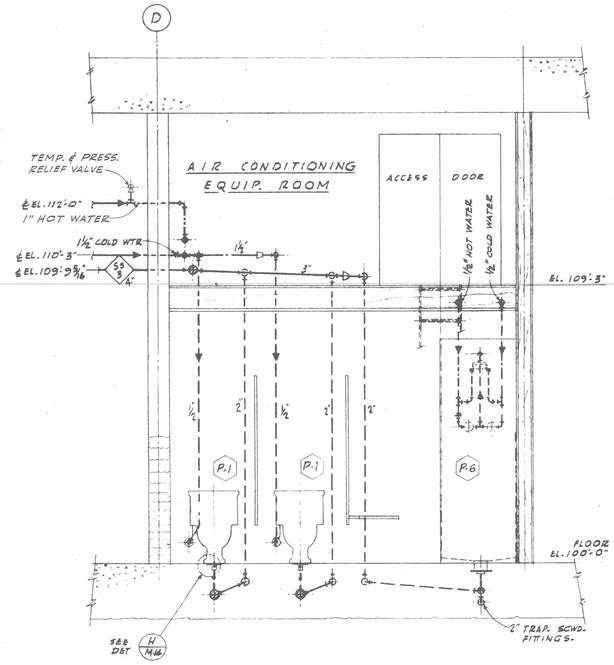

SECTION D M-14 SEE DWG. X2-M-13

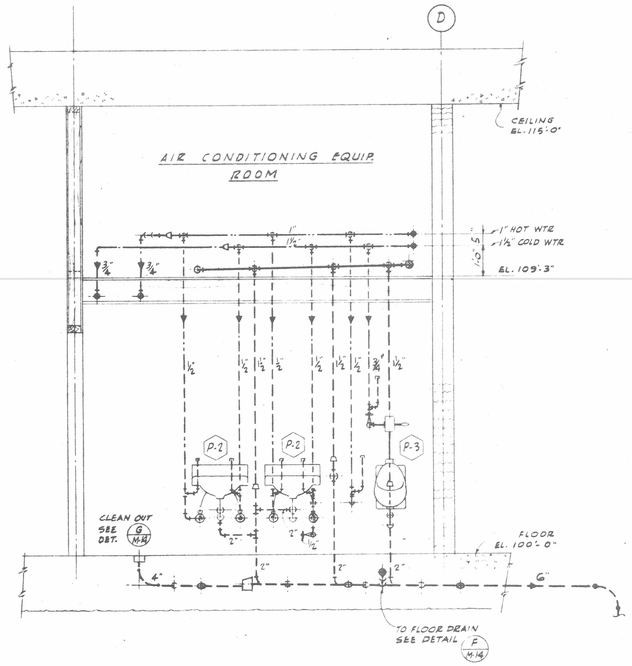

SECTION E M-14 SEE DWG. X2-M-13

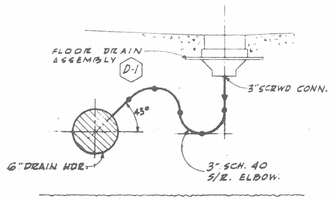

DETAIL F M-14

NO SCALE

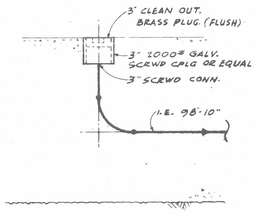

DETAIL G M-14

NO SCALE

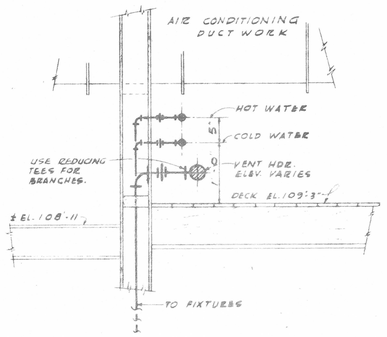

TYP. SECTION C M-11

SCALE 1" = 1'-0"

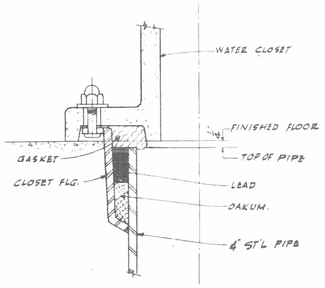

DETAIL H M-14

NO SCALE

½ IN. = 1 FT.

1 IN. = 1 FT.

REVISION	DATE	DESCRIPTION	AGENCY	INIT.
2	12-11-61	OPERATIONAL AS BUILT DWG	BECHTEL	RAR
1	12 MAY 61	CONSTRUCTION AS BUILT DWG	[illegible]	[illegible]

BECHTEL CORPORATION
ENGINEERS AND CONSTRUCTORS
SAN FRANCISCO — LOS ANGELES — NEW YORK

DEPARTMENT OF THE AIR FORCE
AIR FORCE BALLISTIC MISSILE DIVISION (ARDC)
INGLEWOOD, CALIFORNIA

		DATE
DESIGNED BY		
DRAWN BY	J.T. ARMA	4-6-59
CHECKED BY	[illegible]	5-8-59
O.K.	[illegible]	5-21-59
O.K.	[illegible]	5-21-59
APPROVED	BECHTEL CORP.	

WS-107 A-1 OPERATIONAL BASE

FORBES A.F.B. KANSAS

COMPLEXES D, E, F, G, H & I

LAUNCH OPERATIONS BUILDING

PLUMBING SECTIONS & DETAILS

APPROVED — DATE — AFBMD

SPECIFICATION No. ENG-23-028-59

DATE 21 MAY '59 — SCALE AS SHOWN

DRAWING NUMBER 3115-3 X2-M-14 — SHEET

B.M.D. INDEX NO. 5D1.6.1

APPROVED BY

FOR