FOR OFFICIAL USE ONLY

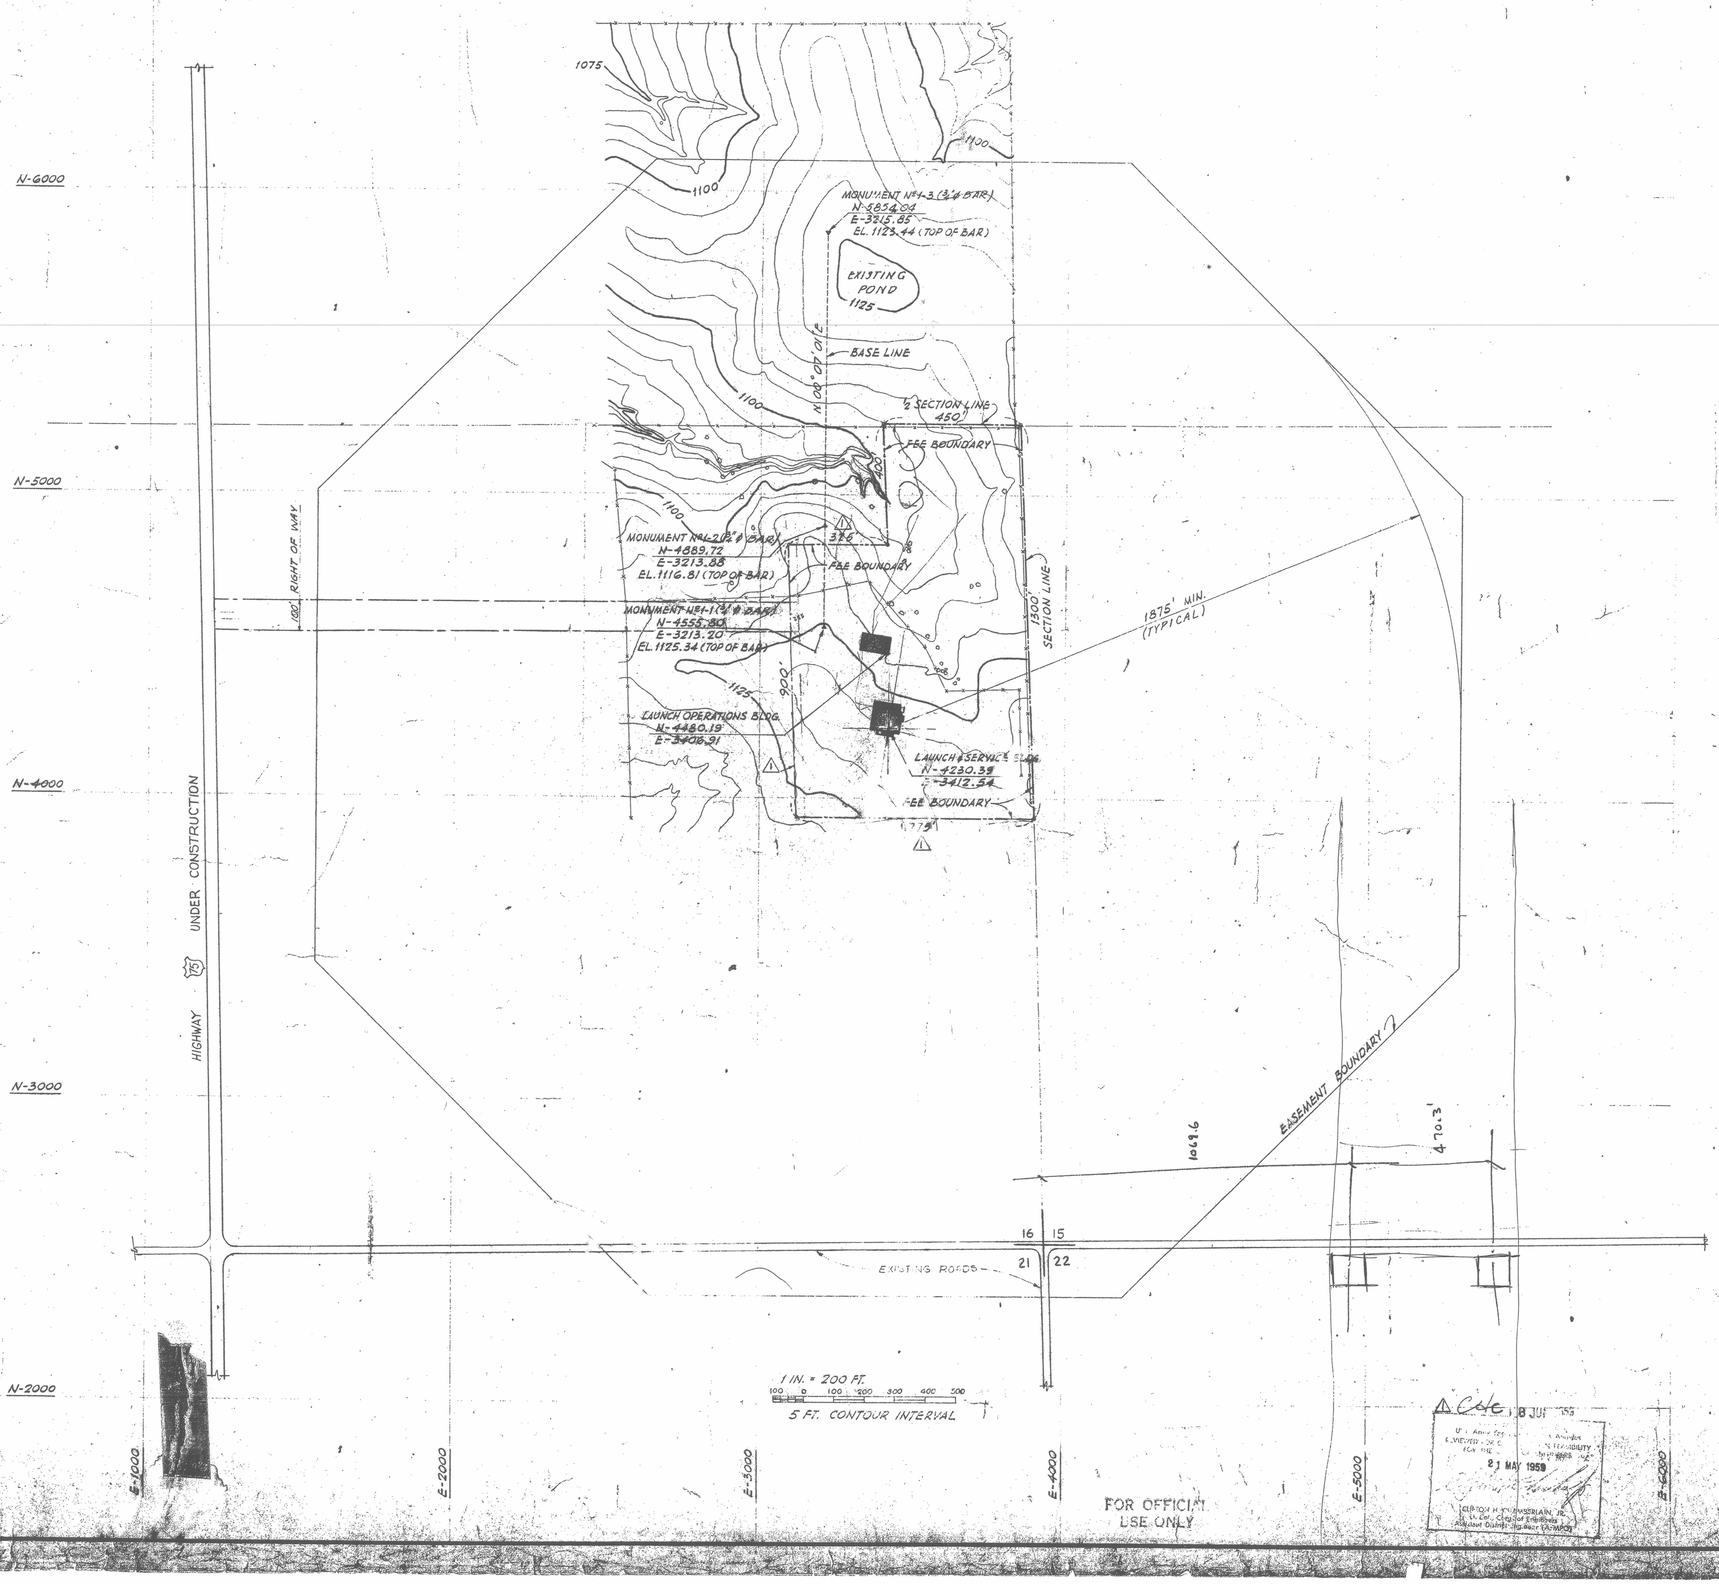

FOR OFFICIAL USE ONLY

1°25'46" N
TRUE NORTH
GRID NORTH

GENERAL NOTES

1. TOPOGRAPHY BY SERVIS, VAN DOREN & HAZARD ENGINEERS OF TOPEKA, KANSAS. BY A STANDARD PHOTOGRAMMETRIC PROCESS FROM AERIAL PHOTOGRAPHS TAKEN 30 JULY 1956.
2. HORIZONTAL GRID LINES HAVE COORDINATES WITH EQUATIONS BASED ON KANSAS (LAMBERT) COORDINATE SYSTEM, NORTH ZONE.
3. ELEVATIONS REFERRED TO MEAN SEA LEVEL, ARE BASED ON THE U.S. COAST & GEODETIC SURVEY 1929 GENERAL ADJUSTMENT, PUBLISHED 17 JUNE 1955.
4. HORIZONTAL CONTROL FROM STATIONS ROUSE & HOLTEN OF U.S. COAST & GEODETIC SURVEY FIRST ORDER TRIANGULATION. GROUND SURFACE MEASUREMENTS.
5. VERTICAL CONTROL FROM U.S. COAST & GEODETIC SURVEY BENCH MARKS ON SECOND ORDER LEVEL LINE; TOPEKA, KANSAS TO NEBRASKA CITY, NEBRASKA.
6. FOR GEOGRAPHIC LOCATION OF PROPERTY, SEE VICINITY MAP SHOWN ON SITE PLAN, DWG. E3-C-2.
7. ALL BEARINGS SHOWN ARE BASED ON (LAMBERT) GRID NORTH.

LEGEND

- EXISTING FENCE
- FEE BOUNDARY
- MONUMENT
- RIGHT OF WAY BOUNDARY

REFERENCE DRAWINGS

3115-3-E3-C-2 COMPLEX E SITE PLAN

REVISION NOTES

1. RELOCATED FEE BOUNDARY LINE ALONG WEST SIDE OF SITE.

REVISION	DATE	DESCRIPTION	AGENCY	INIT.
3	12-11-61	OPERATIONAL AS BUILT DWG	BECHTEL	JT
2	5 12 61	CONSTRUCTION AS BUILT DWG.	KCD	PB
1	6-8-59	SEE REVISION NOTE 1	BECHTEL	JC

BECHTEL CORPORATION
ENGINEERS AND CONSTRUCTORS
SAN FRANCISCO — LOS ANGELES — NEW YORK

DEPARTMENT OF THE AIR FORCE
AIR FORCE BALLISTIC MISSILE DIVISION (ARDC)
INGLEWOOD, CALIFORNIA

DESIGNED BY KLW 5-7-59
DRAWN BY R.F.Z. 5-7-59
CHECKED BY KLW 5-19-59
O.K. 5-19-59
O.K. 5-20-59
APPROVED 5-26-59
BECHTEL CORP.

WS-107 A-I OPERATIONAL BASE

FORBES A.F.B. KANSAS

SITE E.

FEE AND EASEMENT AREAS

A. Gordon Kinghan Captain, USAF MAY 1959
P. Robert K. Harper Captain, USAF MAY 1959
B. Robert K. Harper Captain, USAF MAY 1959
C. Lt. Col. Commdg. MAY 1959
D. Lt. Col. Commdg. MAY 1959

SPECIFICATION NO. ENG-23-028-59
DATE 27 MAY 59 SCALE 1" = 200'
DRAWING NUMBER 3115-3 E3-C-1 SHEET

S.A.D. INDEX NO. 5 D.I.G.I.

APPROVED BY
FOR

Cole 8 JUL 1959

U.S. Army Corps of Engineers
Sacramento District
Real Estate
21 MAY 1959
Sacramento, California
CLIFTON H. CHAMBERLAIN, JR.
Lt. Col., Corps of Engineers
Assistant District Engineer (A/MCO)

FOR OFFICIAL USE ONLY