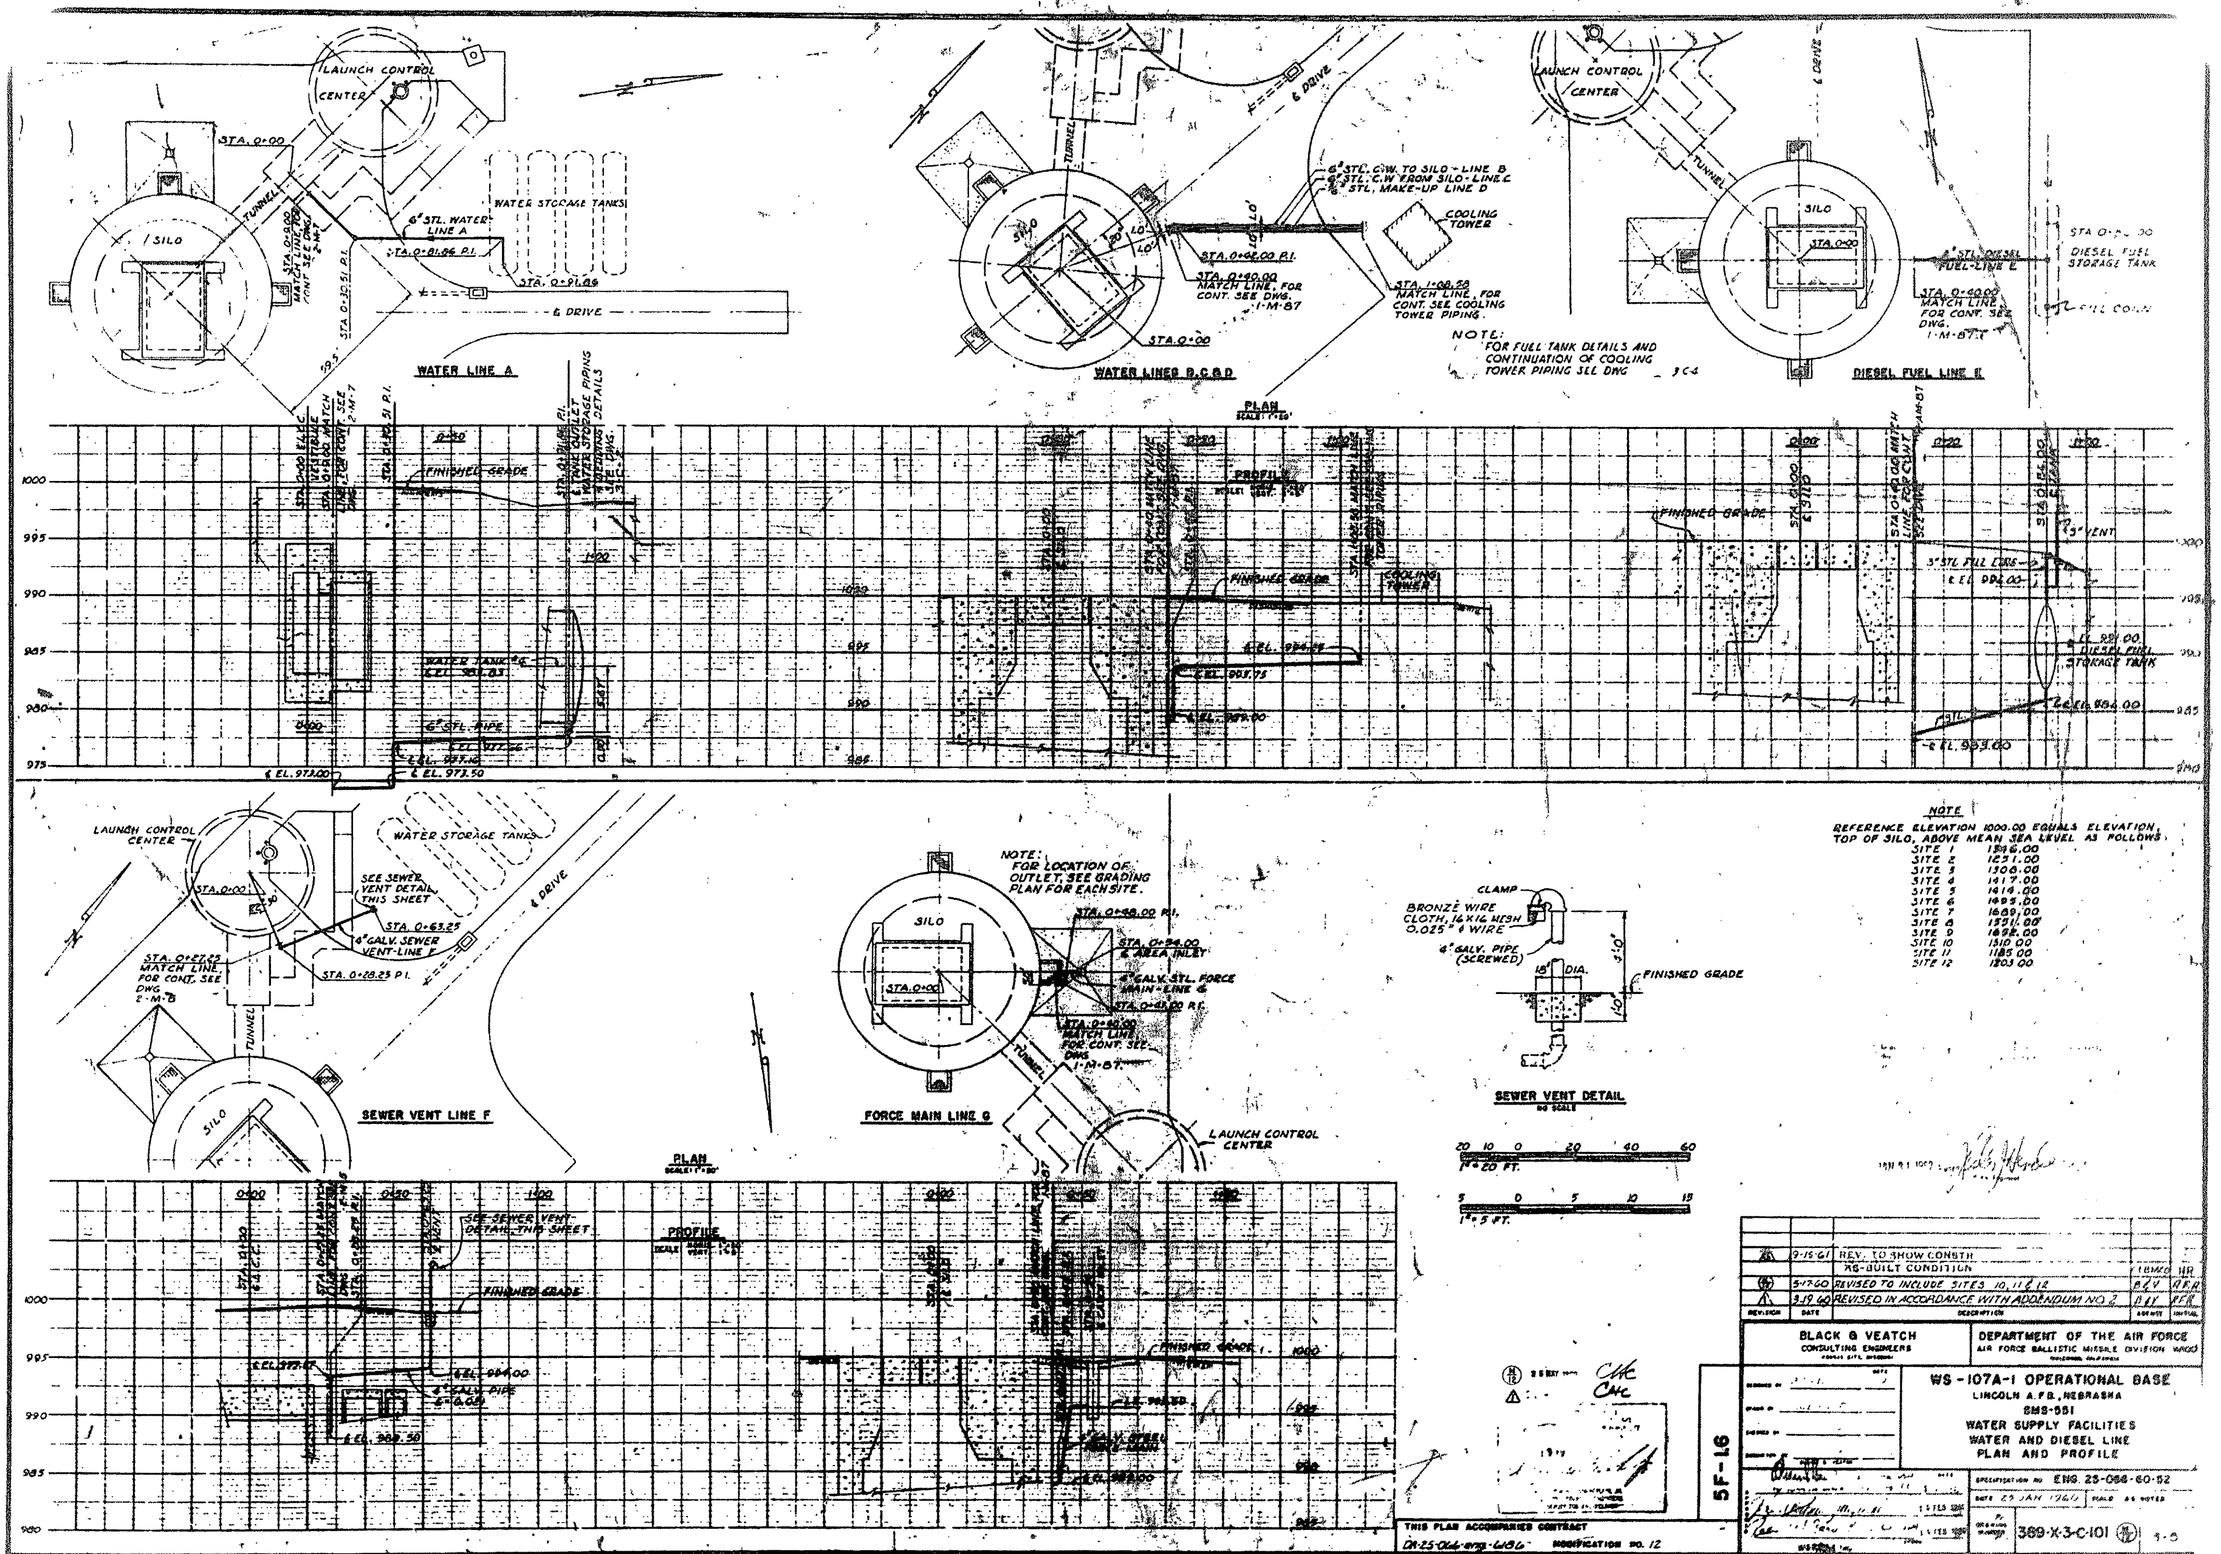

NOTE

REFERENCE ELEVATION 1000.00 EQUALS ELEVATION TOP OF SILO, ABOVE MEAN SEA LEVEL AS FOLLOWS:

SITE 1	1346.00
SITE 2	1251.00
SITE 3	1308.00
SITE 4	1417.00
SITE 5	1414.00
SITE 6	1495.00
SITE 7	1689.00
SITE 8	1551.00
SITE 9	1692.00
SITE 10	1310.00
SITE 11	1185.00
SITE 12	1203.00

REVISION	DATE	DESCRIPTION	AGENCY	INITIAL
	9-15-61	REV. TO SHOW CONSTR. AS-BUILT CONDITION		HR
	5-17-60	REVISED TO INCLUDE SITES 10, 11 & 12		
	3-19-60	REVISED IN ACCORDANCE WITH ADDENDUM NO 2		

BLACK & VEATCH
CONSULTING ENGINEERS

DEPARTMENT OF THE AIR FORCE
AIR FORCE BALLISTIC MISSILE DIVISION WACO

WS-107A-1 OPERATIONAL BASE
LINCOLN A.F.B., NEBRASKA
SMS-551
WATER SUPPLY FACILITIES
WATER AND DIESEL LINE
PLAN AND PROFILE

SPECIFICATION NO. ENG. 25-066-60-52
DATE 25 JAN 1960
SCALE AS NOTED

389-X-3-C-101

5F-16

THIS PLAN ACCOMPANIES CONTRACT
DA-25-066-eng-6186 MODIFICATION NO. 12