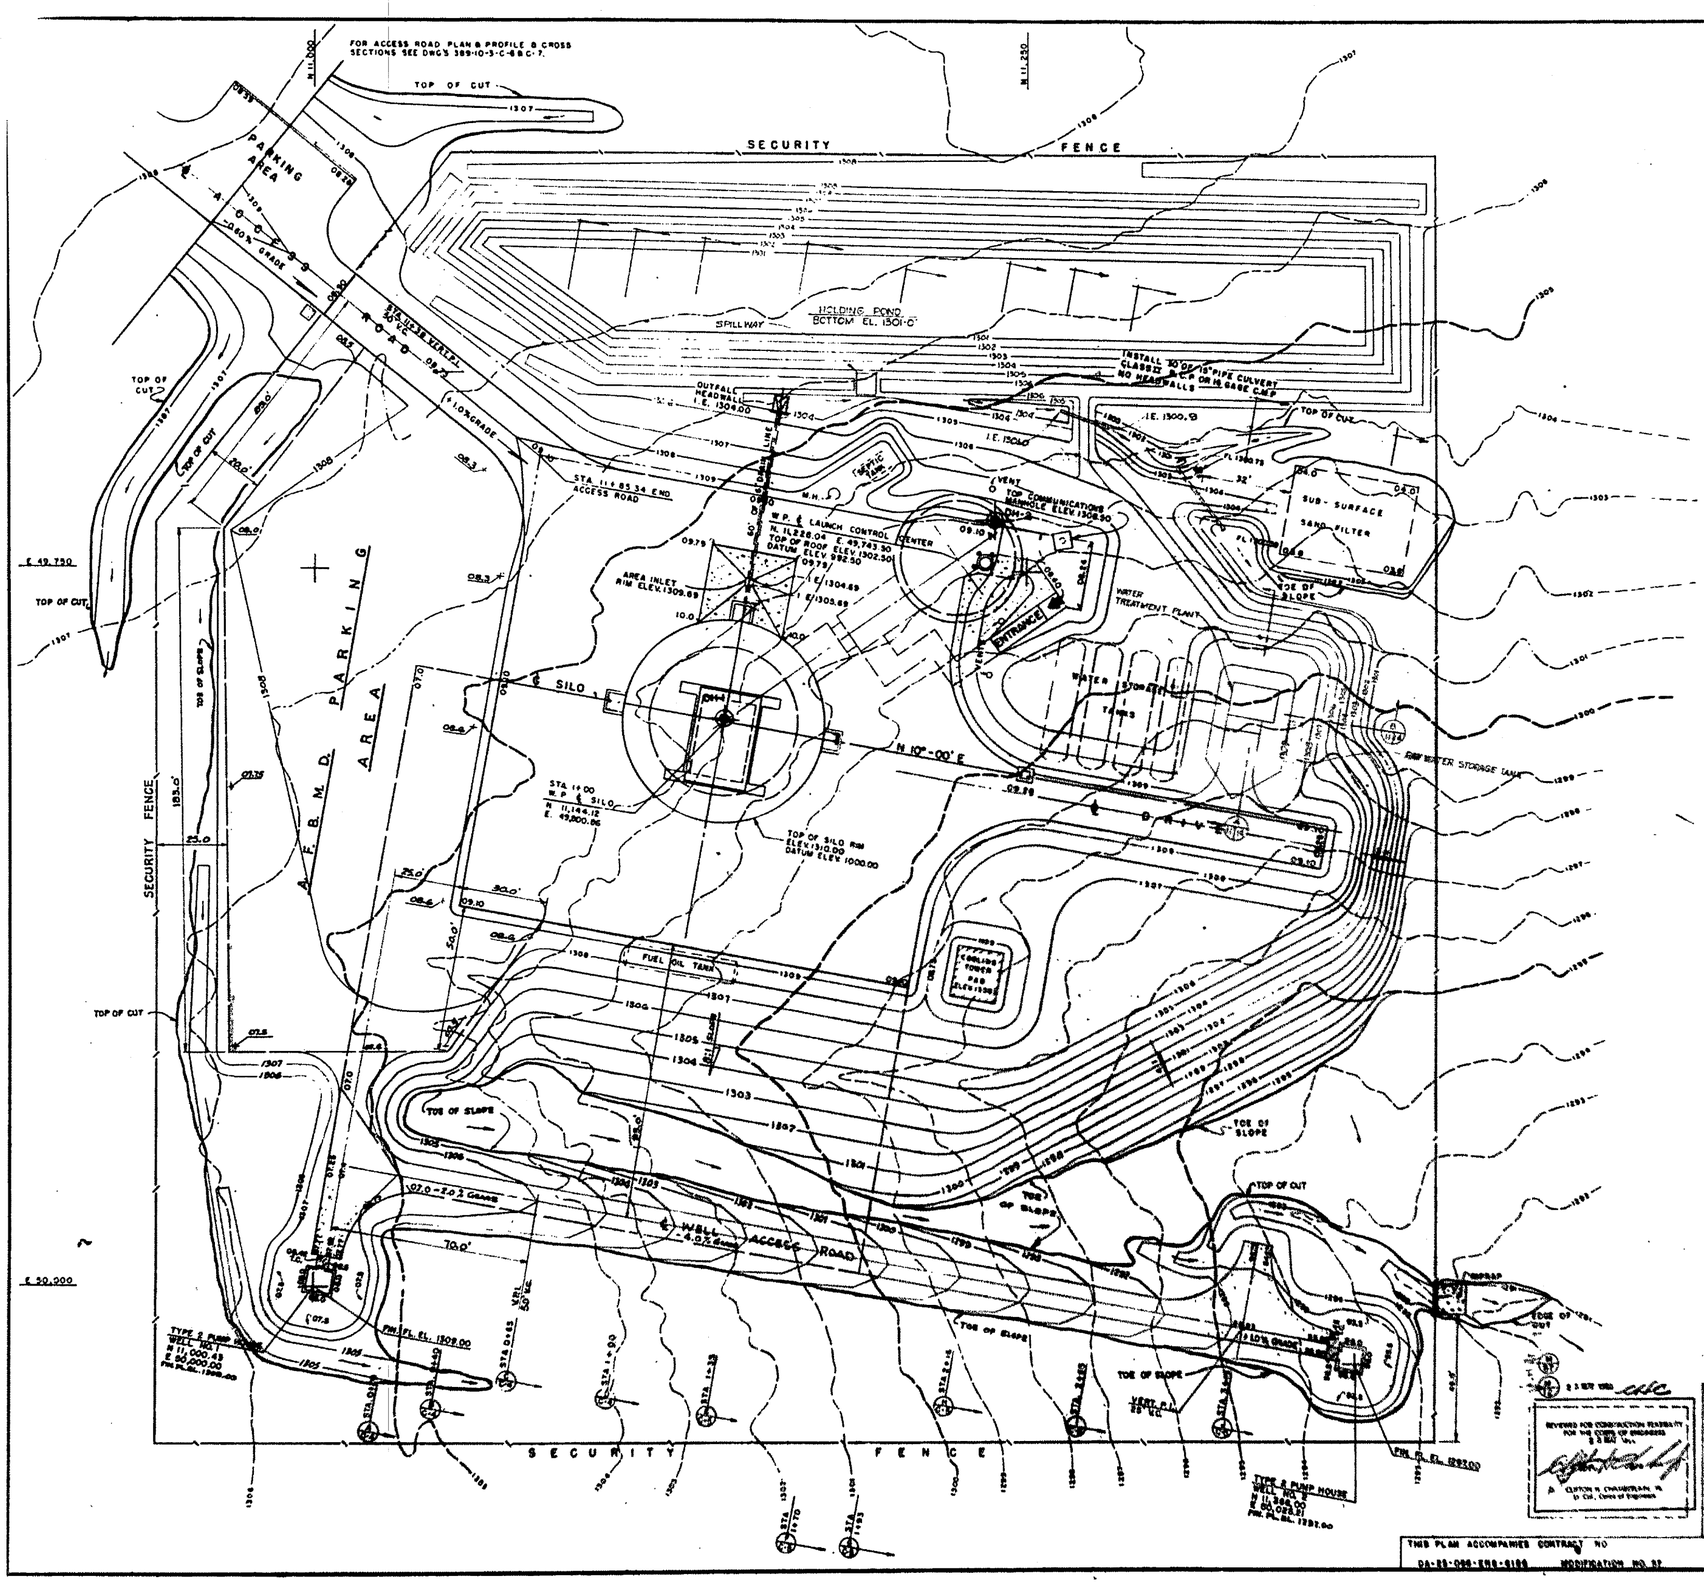

DH-1 **LEGEND**
BORINGS (TOTAL 2) FOR LOGS OF BORINGS SEE DWG. 389-10-3-S-51, S-52

JAN 31 1962

Notes:

1. Topography by Standard Photogrammetric Process from Aerial Photography. Topography Furnished by Corps of Engineers, Omaha District.
2. For Earthwork Cross Sections See Dwg 389-10-3-C-4 & C-5.
3. Security Fence to be Constructed on Natural Ground unless Otherwise Indicated.
4. For details of Outfall Headwall & Riprap See Dwg. 389-X-3-C-102.
5. For details of Area Inlet See Dwg. 389-X-3-C-2.
6. For details of Fence Drainage Structure See Dwg 389-X-3-C-3.
7. For water treatment plant cross sections see Dwg RW 16-06-106 sheet 14

GRAPHIC SCALE - FEET

REVISION	DATE	DESCRIPTION	AGENCY	APPROVAL
	12-29-61	REV. TO SHOW CONSTR. AS-BUILT CONDITION		
	10-18-60	New Drawing Added		
	5-17-60			

BLACK & VEATCH
CONSULTING ENGINEERS
KANSAS CITY, MISSOURI

DEPARTMENT OF THE AIR FORCE
AIR FORCE BALLISTIC MISSILE DIVISION
INGLEWOOD, CALIFORNIA

WS-107A-1 OPERATIONAL BASE
LINCOLN A.F.B., NEBRASKA
SMS-551-10 ELMWOOD

GRADING PLAN

DESIGNED BY R.E.J. 5-17-60
DRAWN BY J.M.W. 5-17-60
CHECKED BY A.S.B. 5-17-60
SUBMITTED BY 5-17-60

SPECIFICATION NO. ENG 25-068-60-52
DATE 17 MAY 1960
DRAWING NUMBER 389-10-3-C-3

5F-1.6.19

THIS PLAN ACCOMPANIES CONTRACT NO DA-25-068-ENG-6188 MODIFICATION NO. 37