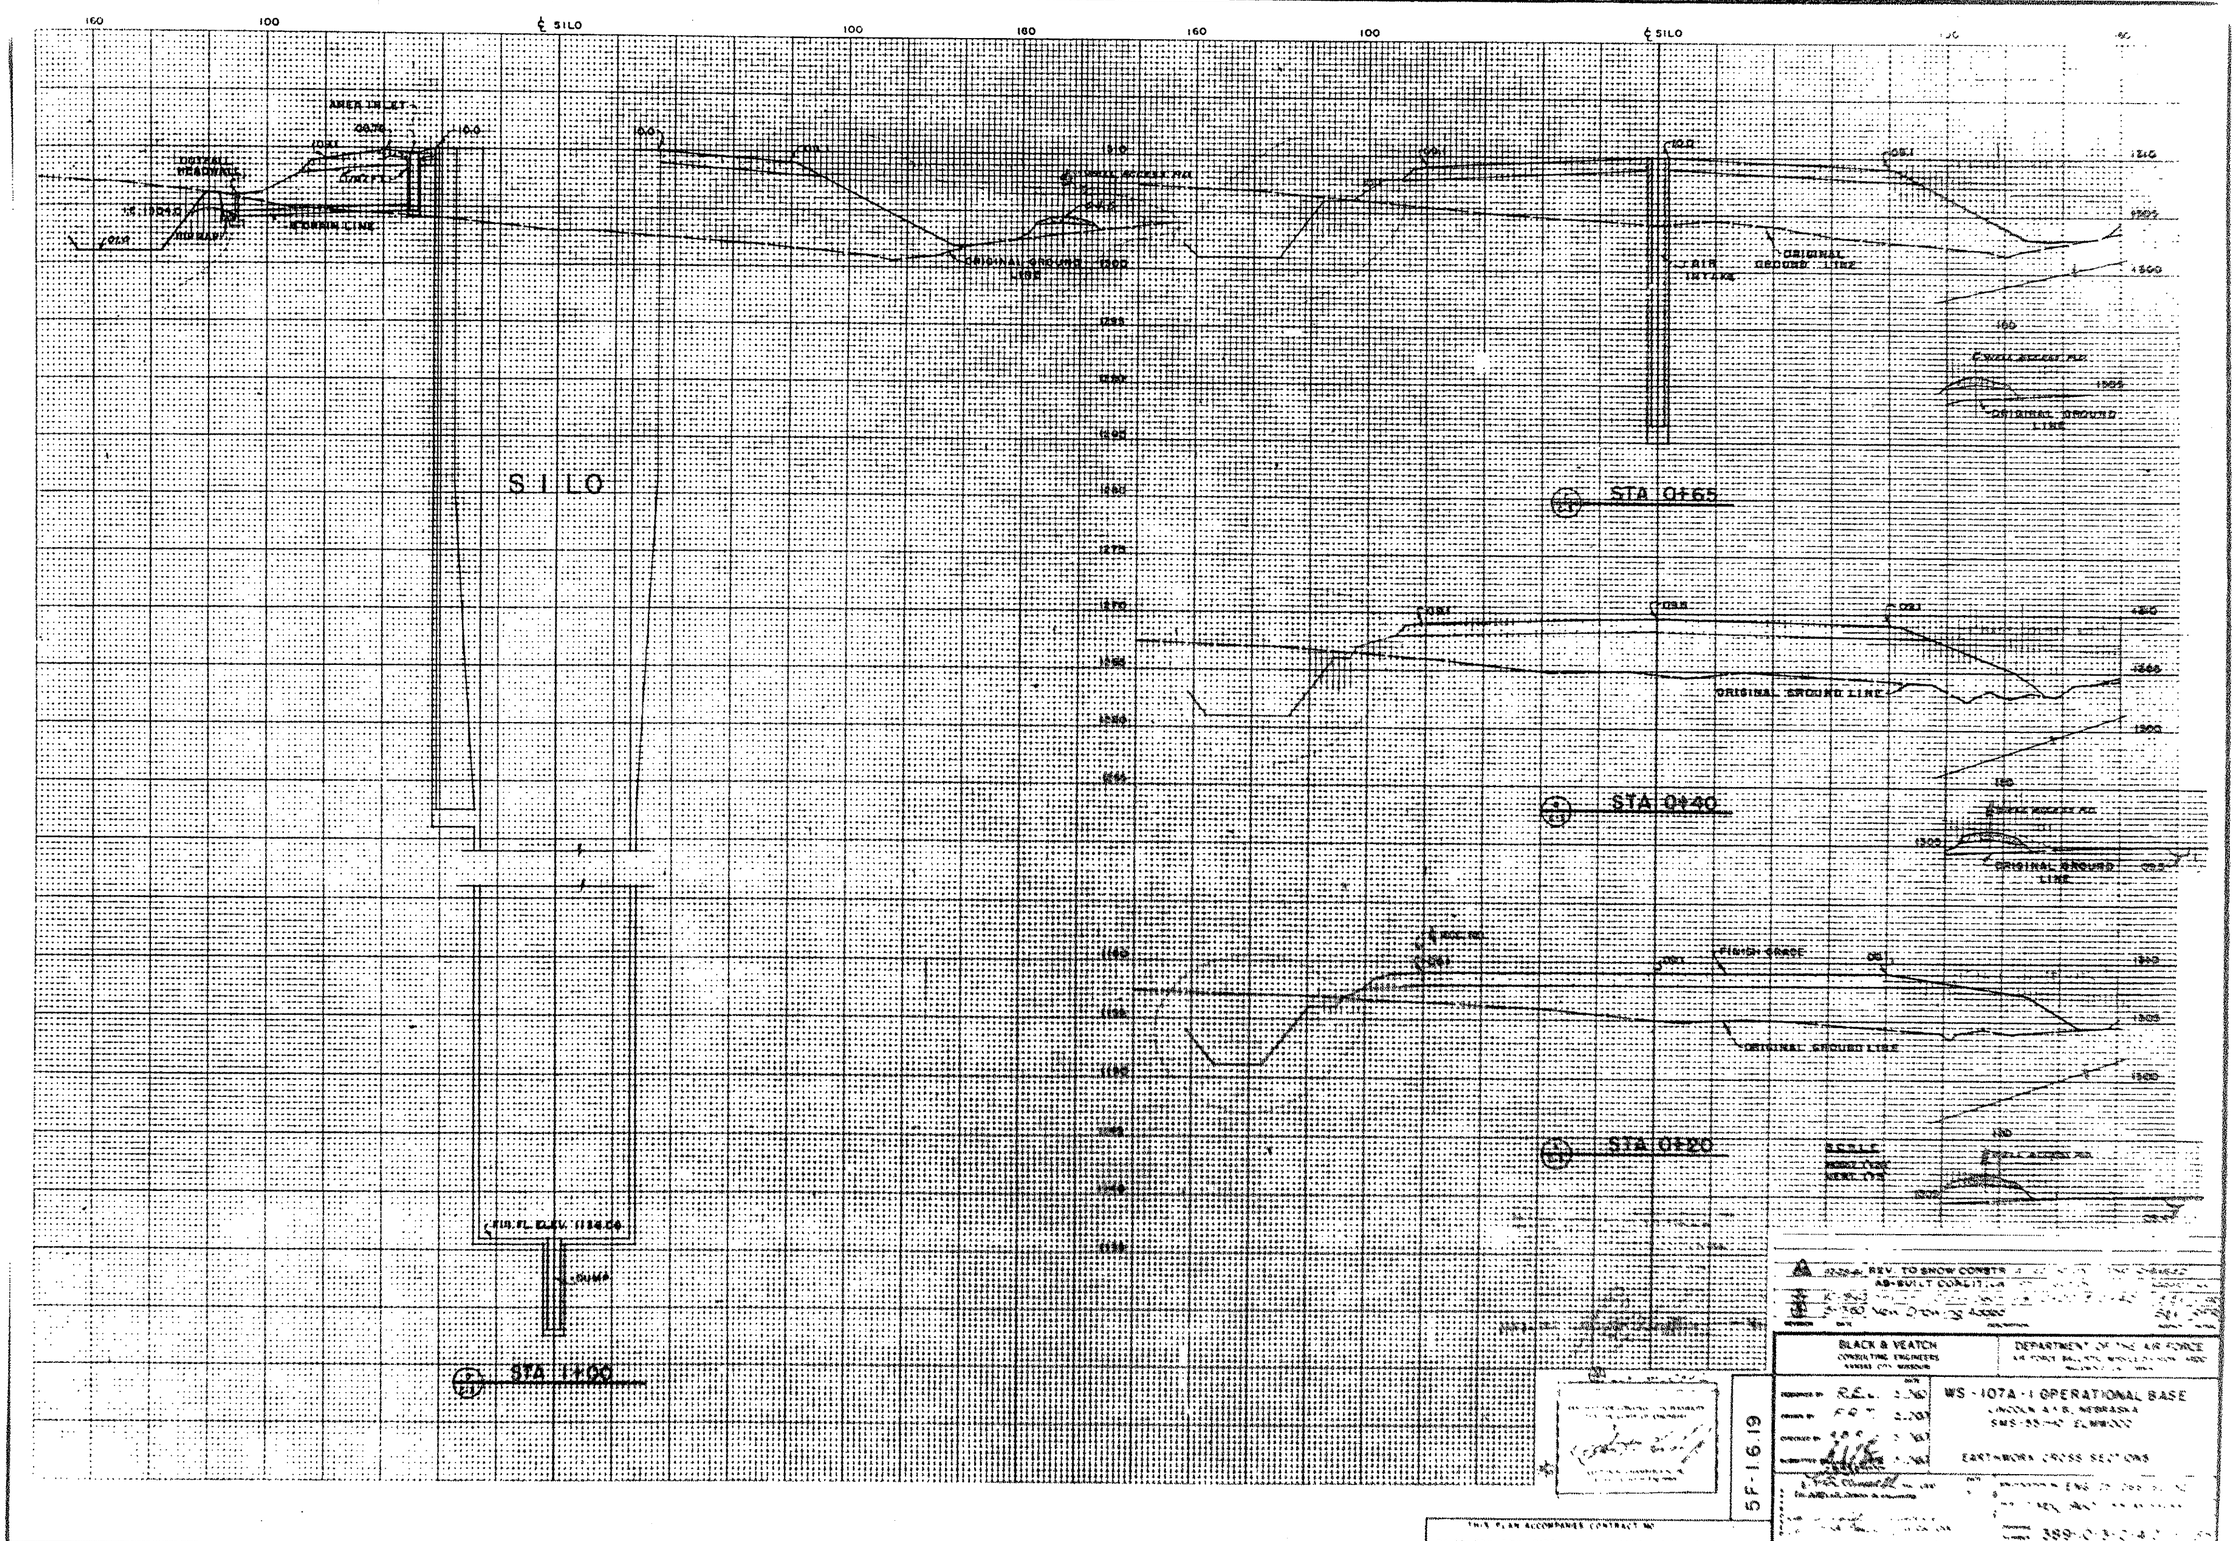

SILO
STA 0+65
STA 0+40
STA 0+20
STA 1+00
ORIGINAL GROUND LINE
FINISH GRADE
AIR INTAKE
DUMP
REV. TO SHOW CONSTR
AS-BUILT CONDITION
BLACK & VEATCH
CONSULTING ENGINEERS
DEPARTMENT OF THE AIR FORCE
WS-107A-1 OPERATIONAL BASE
LINCOLN A.F.B., NEBRASKA
EARTHWORK CROSS SECTIONS
5F-1.6.19
THIS PLAN ACCOMPANIES CONTRACT NO