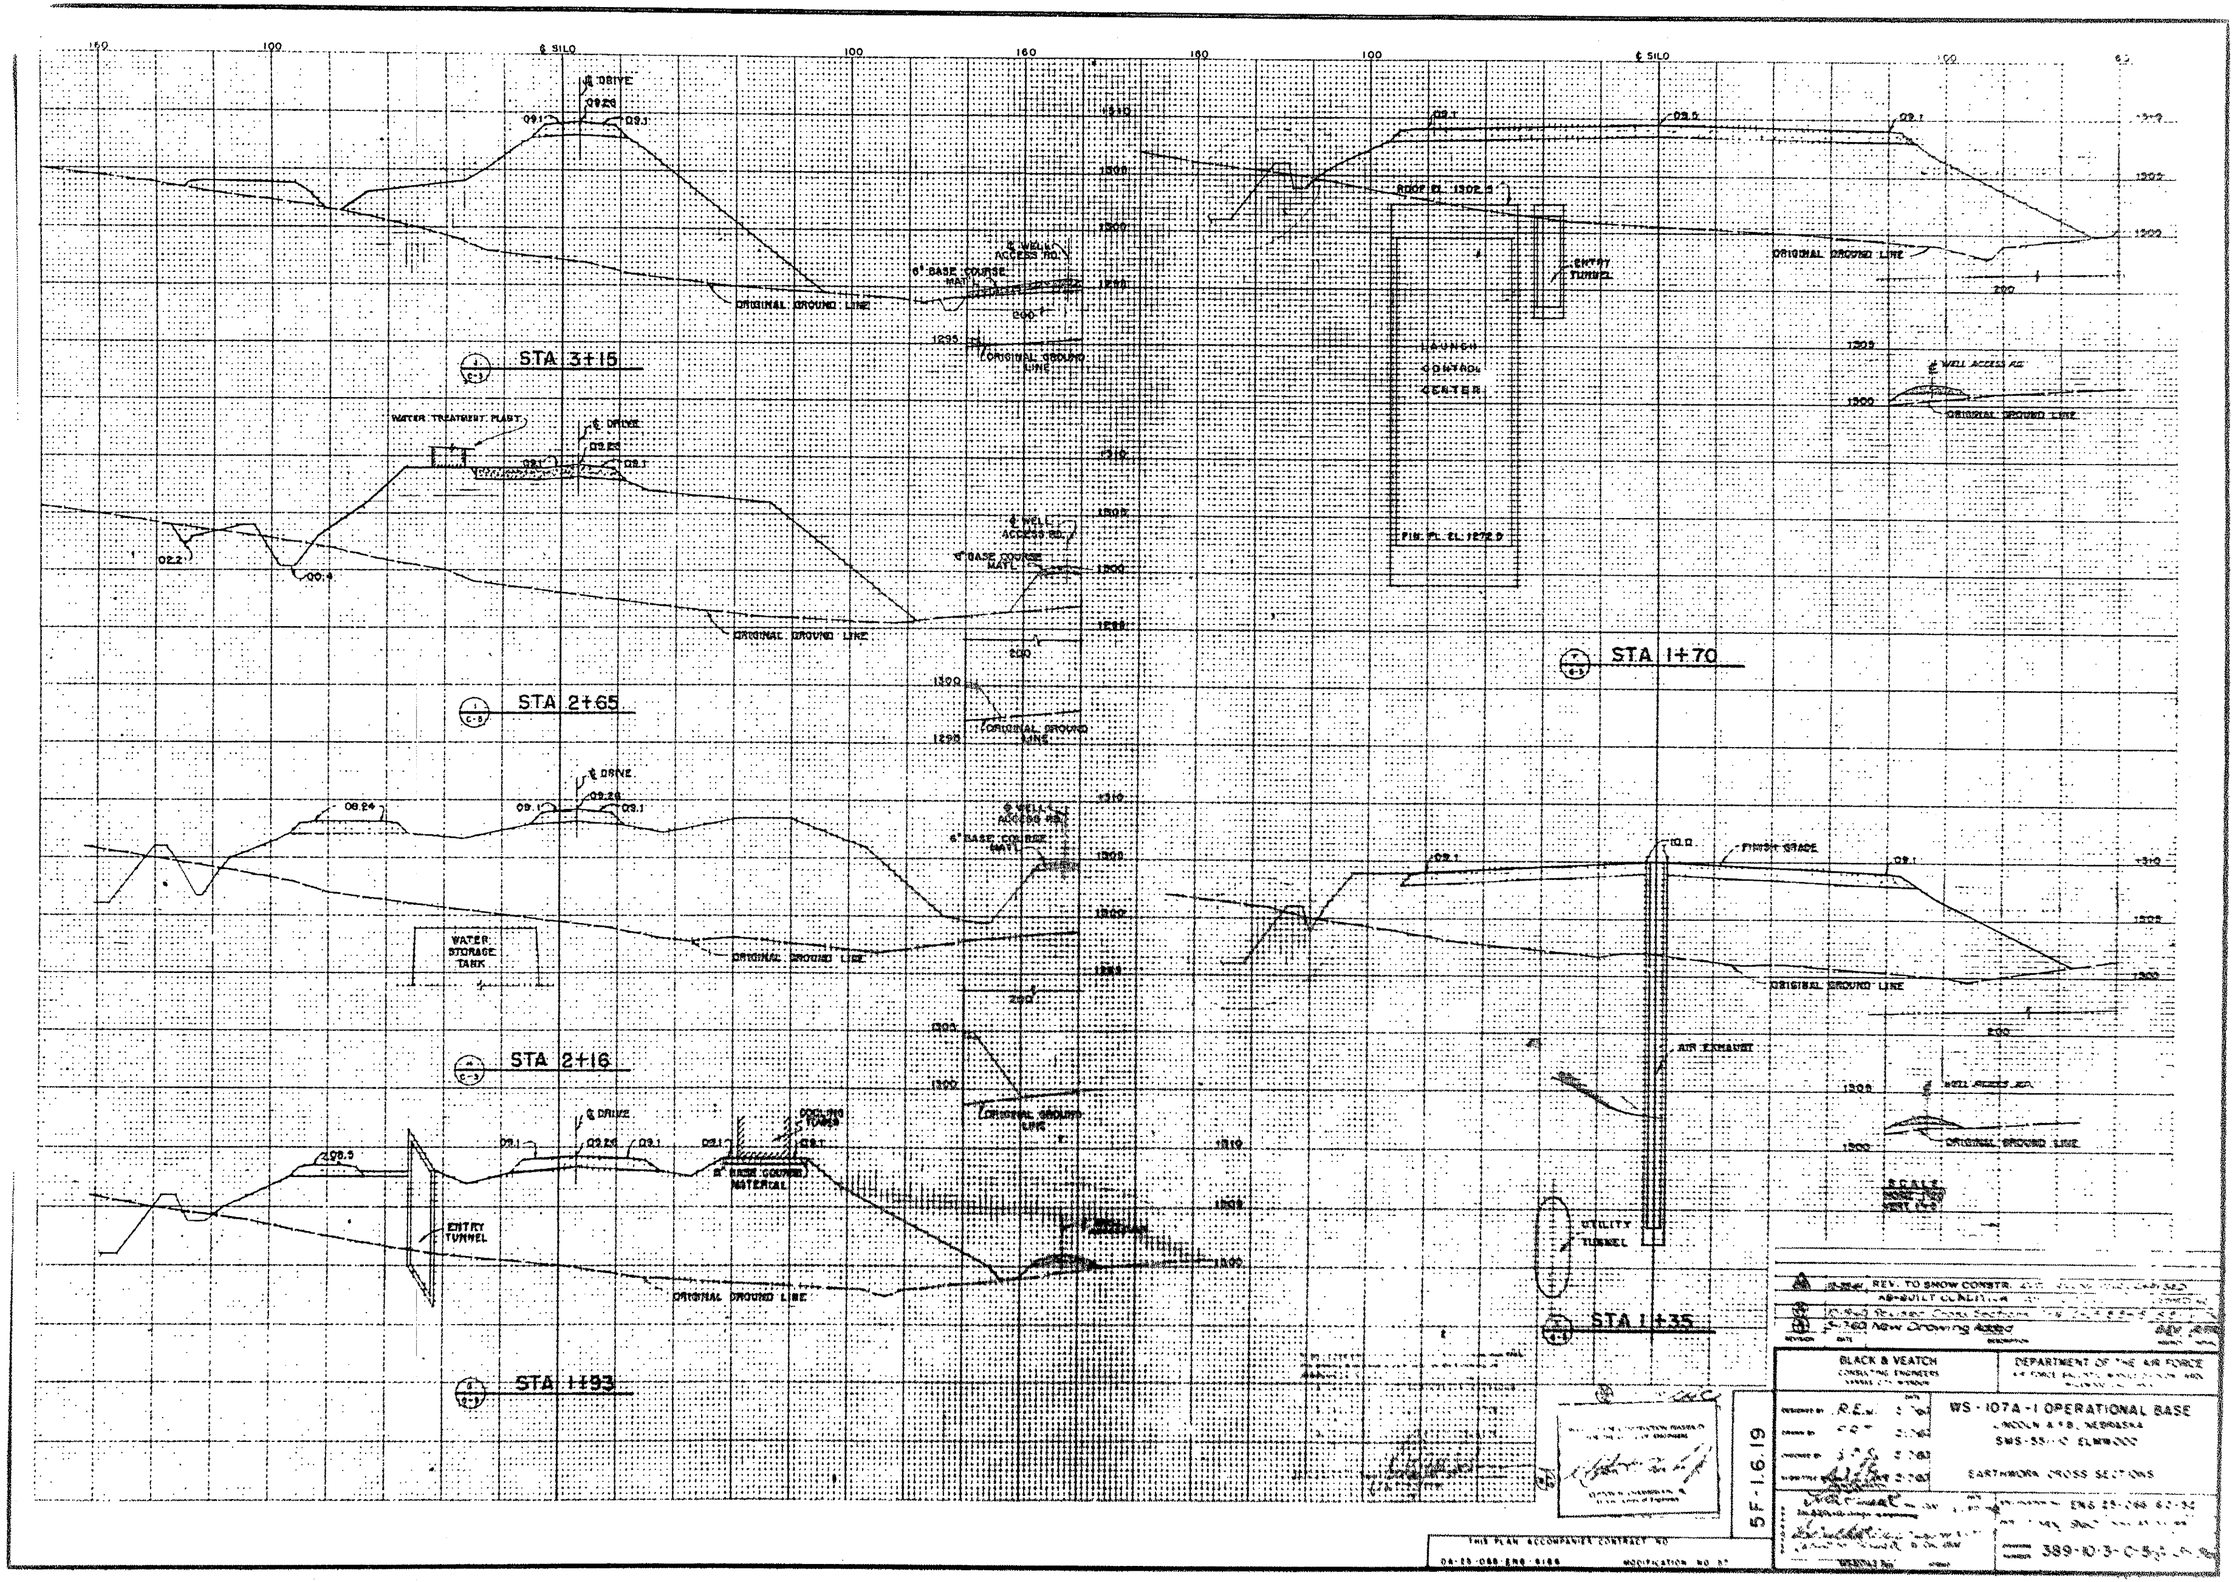
STA 3+15
STA 2+65
STA 2+16
STA 1+93
STA 1+70
STA 1+35
℄ SILO
℄ DRIVE
ORIGINAL GROUND LINE
6" BASE COURSE MAT'L
℄ WELL ACCESS RD.
WATER TREATMENT PLANT
WATER STORAGE TANK
ENTRY TUNNEL
BASE COURSE MATERIAL
ROOF EL. 1302.5
LAUNCH CONTROL CENTER
FIN. FL. EL. 1272.9
FINISH GRADE
AIR EXHAUST
UTILITY TUNNEL
REV. TO SHOW CONSTR. AS-BUILT CONDITION
New Drawing Added
BLACK & VEATCH
CONSULTING ENGINEERS
DEPARTMENT OF THE AIR FORCE
WS-107A-1 OPERATIONAL BASE
LINCOLN A.F.B., NEBRASKA
EARTHWORK CROSS SECTIONS
5F-1.6.19
THIS PLAN ACCOMPANIES CONTRACT NO.
MODIFICATION NO.