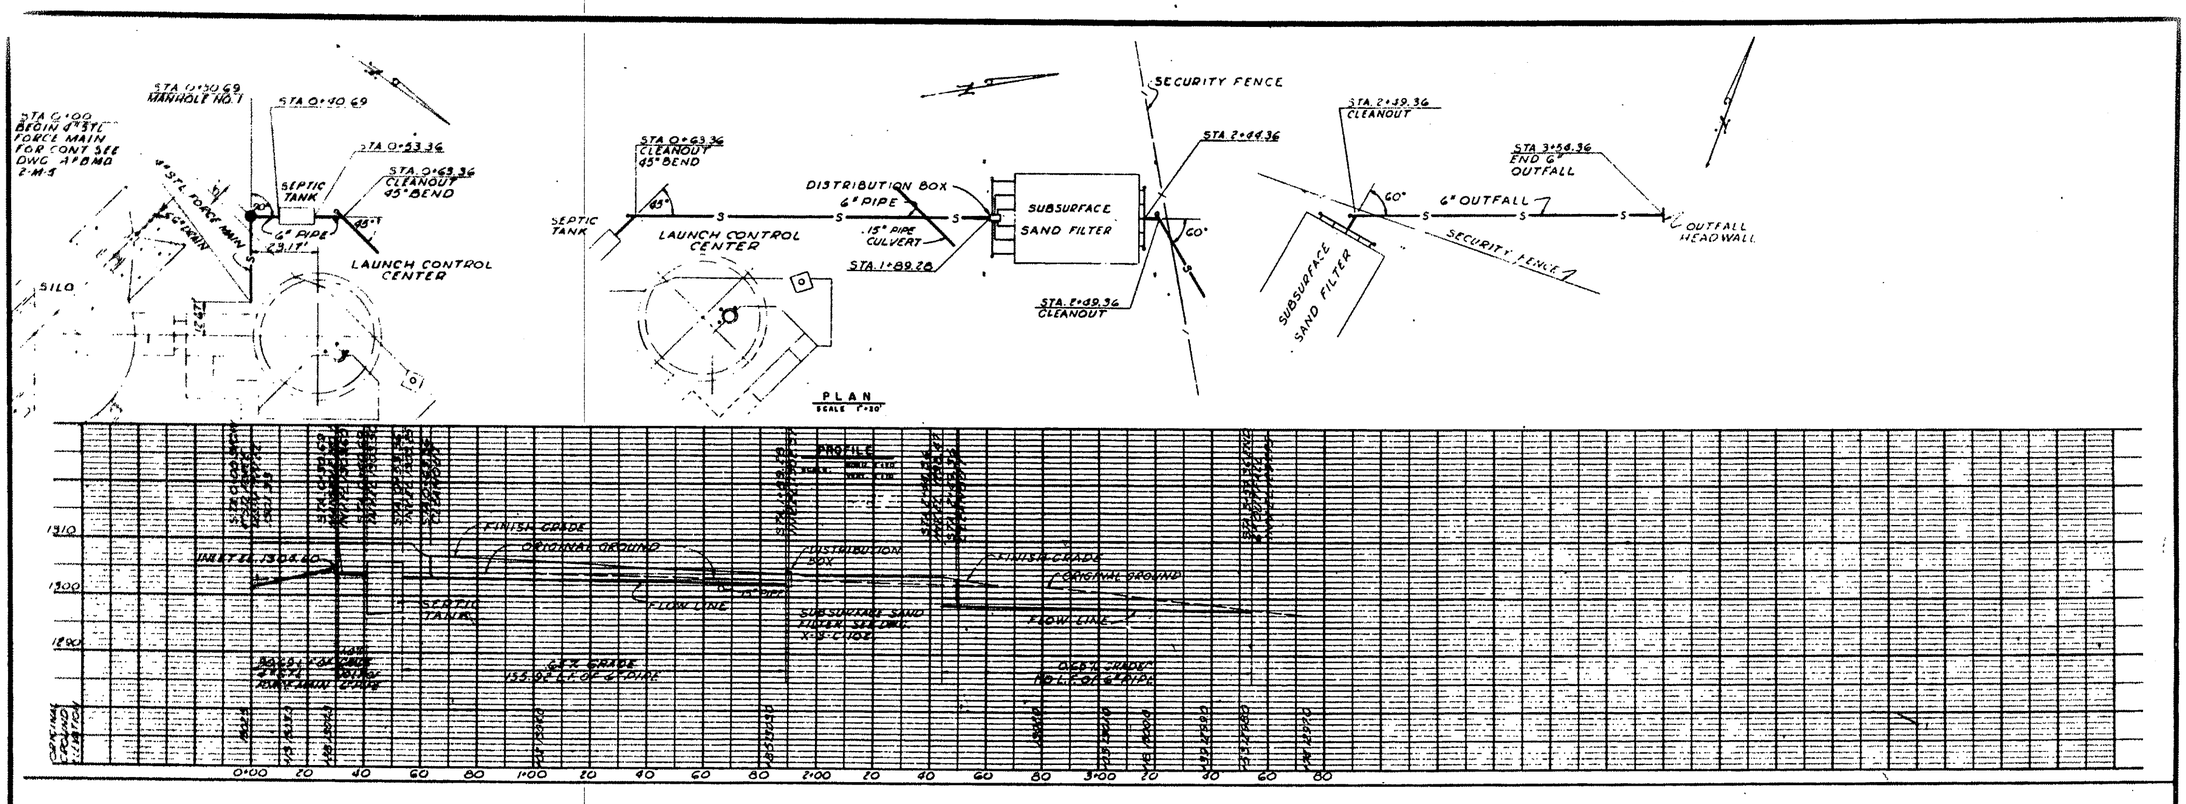

REVISION	DATE	DESCRIPTION	AGENCY	INITIAL
	12-28-61	REV. TO SHOW CONSTR. AS-BUILT CONDITION	CEBMC	
	51760	NEW DRAWING ADDED	B/V	RFR

BLACK & VEATCH
CONSULTING ENGINEERS
KANSAS CITY, MISSOURI

DEPARTMENT OF THE AIR FORCE
AIR FORCE BALLISTIC MISSILE DIVISION (ARDC)
INGLEWOOD, CALIFORNIA

DESIGNED BY BOYD 5-60
DRAWN BY BLAKE 5-60
CHECKED BY CALLAHAN 5-60
SUBMITTED BY 5-60

WS-107A-1 OPERATIONAL BASE
LINCOLN A.F.B., NEBRASKA
SMS-551-10 ELMWOOD

SANITARY SEWERS
PLAN AND PROFILE

SPECIFICATION NO. ENG. 25-066-60-52
DATE 17 MAY 1960 SCALE AS NOTED
DRAWING NUMBER 389-10-3-C-102 3-40

5F-1.6.21

THIS PLAN ACCOMPANIES CONTRACT NO. DA-25-066-eng-6186 MODIFICATION NO. 12

JAN 31 1962

REVIEWED FOR CONSTRUCTION FEASIBILITY FOR THE CORPS OF ENGINEERS

17