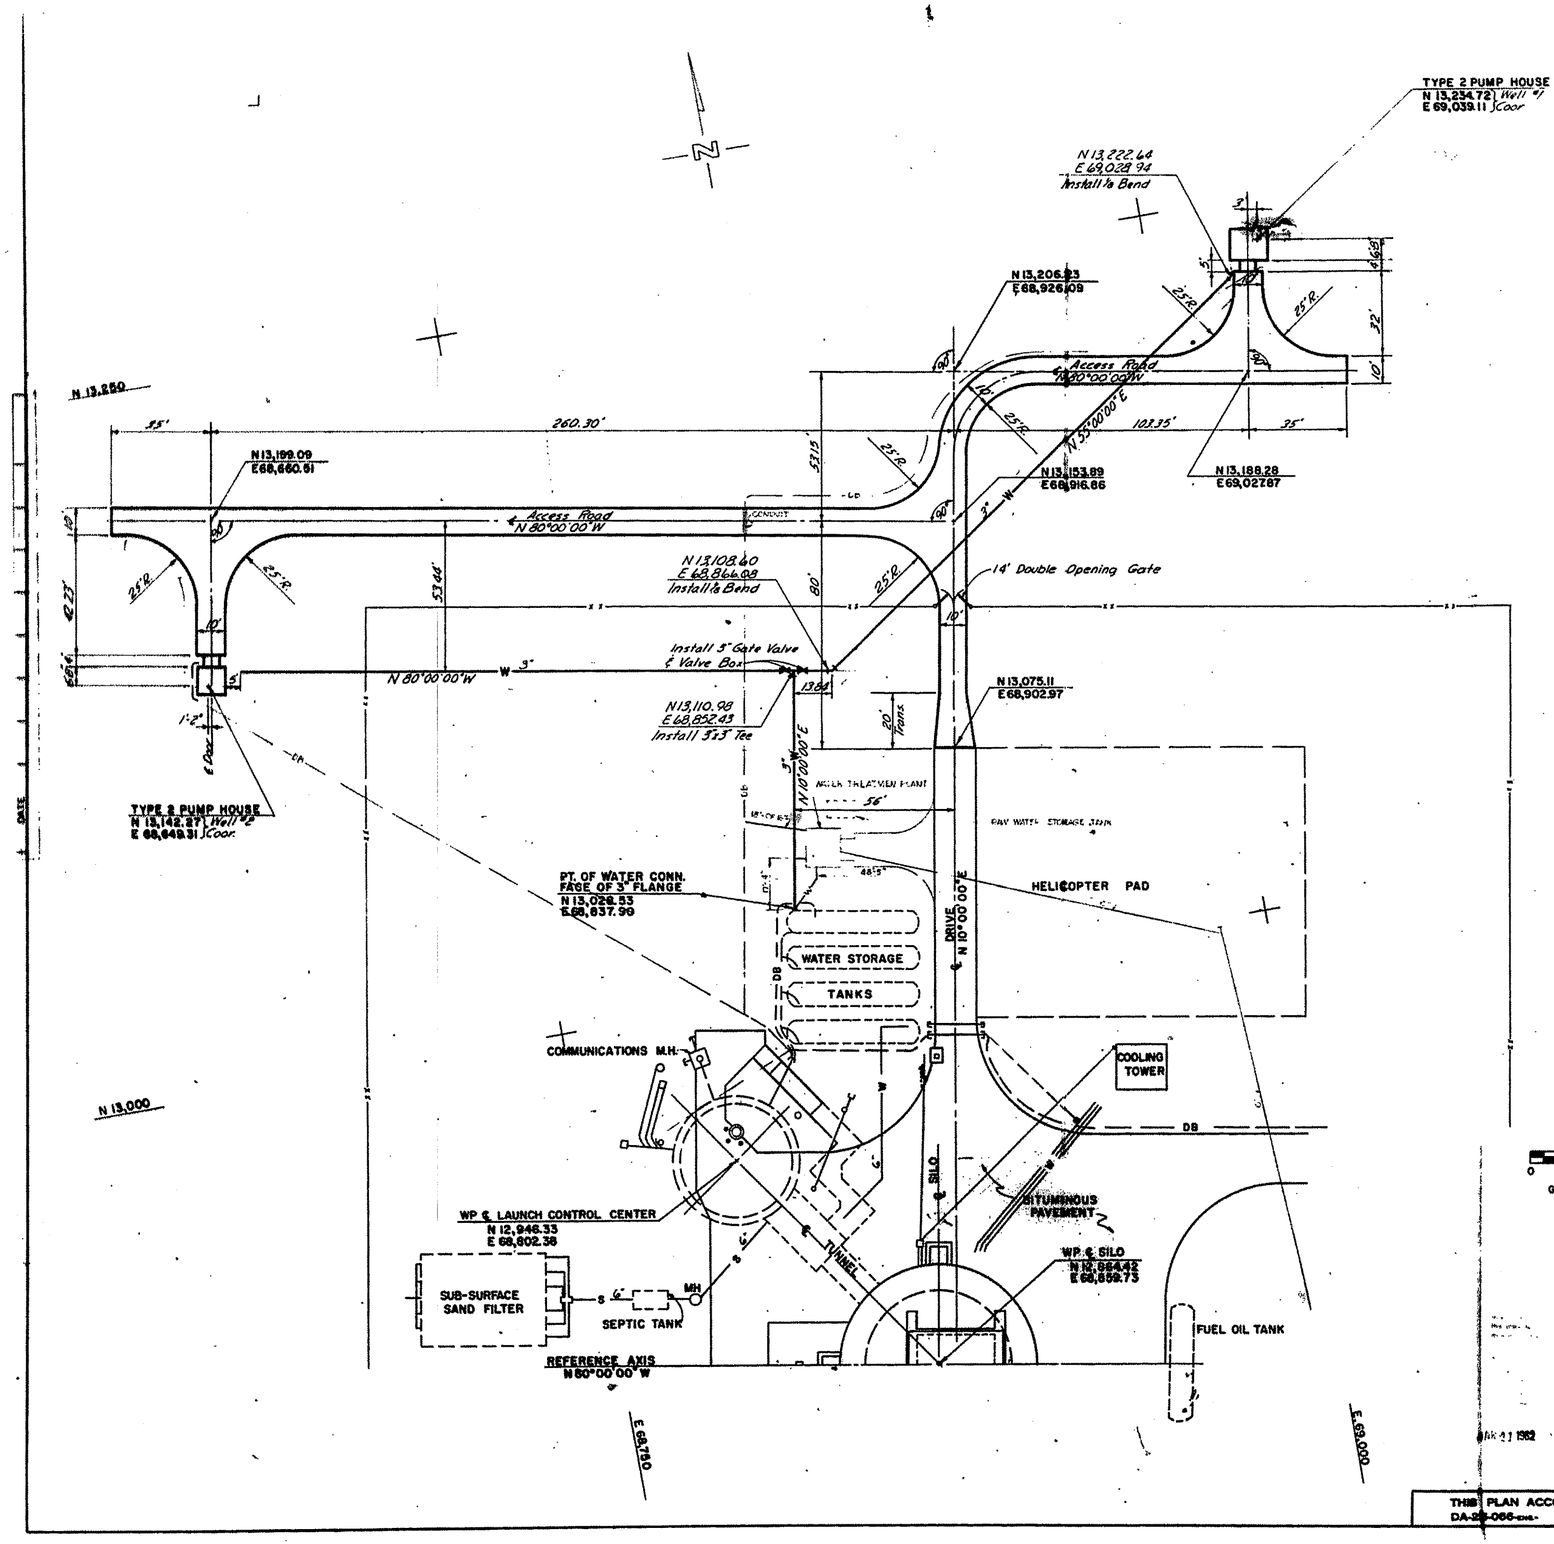

GENERAL NOTES

1. FOR THE NUMBER & SIZE OF CONDUCTORS IDENTIFIED BY "DB", REFER TO DRAWING 389-4-3-E-1.

DATE	DESCRIPTION	MADE	APPR'D
12-28-61	REV. TO SHOW CONSTR. AS-BUILT CONDITION		
4-1-60	Revised in accordance with Addendum No. 7		
3-19-60	Revised in accordance with Addendum No. 2	B&V	RFR
3-11-60	Add No. 1 New Drawing Added	KMA	RFR

REVISIONS

KIRKHAM, MICHAEL AND ASSOCIATES
ARCHITECTS-ENGINEERS
OMAHA, NEBRASKA

U.S. ARMY ENGINEER DISTRICT
OMAHA
CORPS OF ENGINEERS
OMAHA, NEBRASKA

DESIGNED BY: TMR
DRAWN BY: ALM
TRACED BY: ALM
CHECKED BY: BBM
SUBMITTED BY: R. E. Kirkham, KIRKHAM, MICHAEL AND ASSOCIATES
APPROVED: Ralph F. Rader, CHIEF, MILITARY BRANCH
APPROVED: W. G. Hammond, COL., C.E., DISTRICT ENGINEER

LINCOLN A.F.B. LINCOLN, NEBRASKA

WS-107A-1 OPERATIONAL BASE

SMS-551-4
LAYOUT PLAN, WATER SYSTEM & ELECT. DIST.

SB MCAF ADV. 800-000

APPROVED: J. O. Ackerman, CHIEF, ENGINEERING DIVISION

DATE 7 MARCH 1960

SCALE AS SHOWN SPEC. NO. ENG 23-066-60-32

DRAWING NUMBER

SHEET 9 OF AW 16-06-95

THIS PLAN ACCOMPANIES CONTRACT NO. DA-23-066-ENG- , MODIFICATION NO.