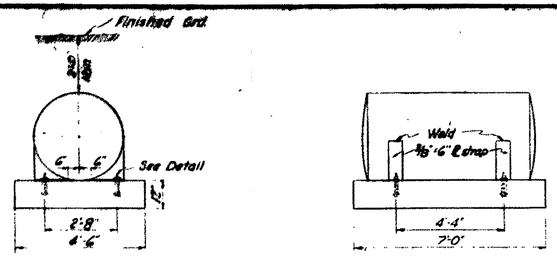

GAS TANK & BASE DETAIL

SCALE 1/4" = 1'-0"

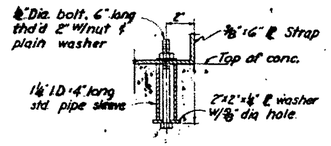

ANCHOR DETAIL

NO SCALE

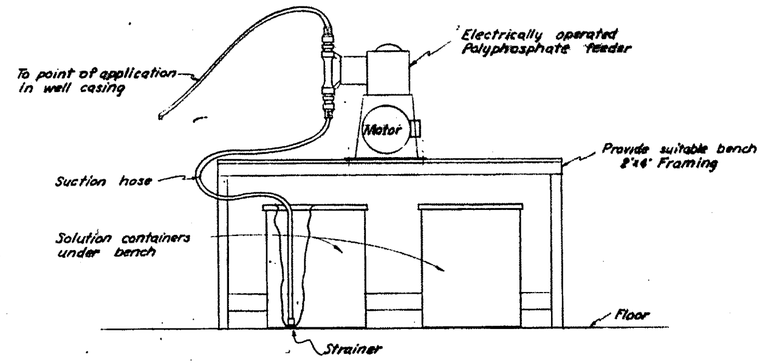

ELECTRICALLY OPERATED POLYPHOSPHATE FEEDER

NO SCALE

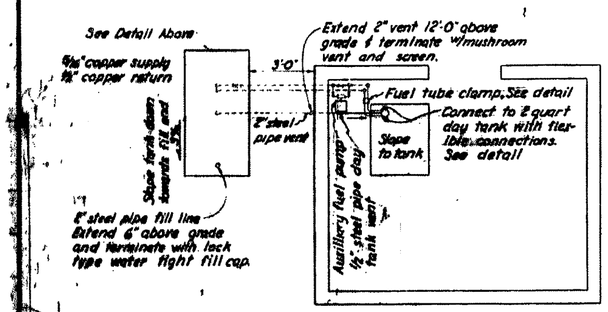

PLAN

NO SCALE

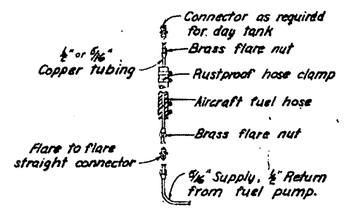

FUEL CONNECTIONS

NO SCALE

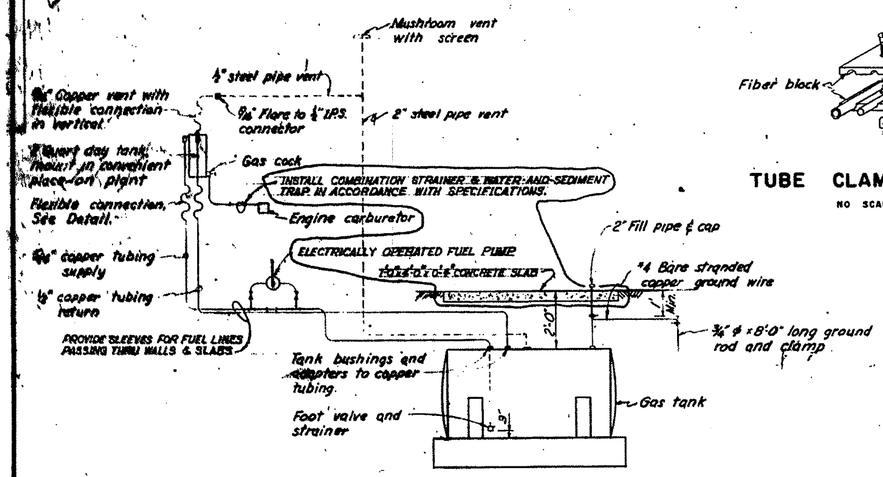

GASOLINE SYSTEM SCHEMATIC

NO SCALE

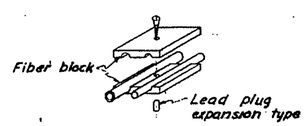

TUBE CLAMP DETAIL

NO SCALE

MAR 6 1962

DATE	DESCRIPTION	MADE	APPR'D
2-14-62	REVISED TO SHOW CONSTRUCTION AS BUILT CONDITION; REV. NOTES & ADDED CONCRETE SLAB.	CEBMCO	AN
3-29-60	Revised in accordance with Addendum No. 5	B&V	RFR
3-11-60	Add. No. 1 New Drawing Added	KMA	RFR

REVISIONS

KIRKHAM, MICHAEL AND ASSOCIATES
ARCHITECTS-ENGINEERS
OMAHA, NEBRASKA

U.S. ARMY ENGINEER DISTRICT
OMAHA
CORPS OF ENGINEERS
OMAHA, NEBRASKA

DESIGNED BY: T.M.R.
DRAWN BY: R.M.R.
TRACED BY: R.M.R.
CHECKED BY: B.B.M.
SUBMITTED BY: R. G. Kirkham

LINCOLN A.F.B. LINCOLN, NEBRASKA

WS-107A-1 OPERATIONAL BASE
GASOLINE TANK
DETAILS

59 MCAF ADV 800-000

APPROVED: Ralph F. Rader, CHIEF, MILITARY BRANCH
APPROVED: J. O. Ackerman, CHIEF, ENGINEERING DIVISION
DATE: 7 MARCH 1960
APPROVED: W. G. Hammond, COL., U.S.E., DISTRICT ENGINEER
SCALE AS SHOWN
SPEC. NO. ENG 25-066 60 52
DRAWING NUMBER
SHEET 3 OF AW 26-09-02

THIS PLAN ACCOMPANIES CONTRACT NO. DA-25-066-ENG. MODIFICATION NO.