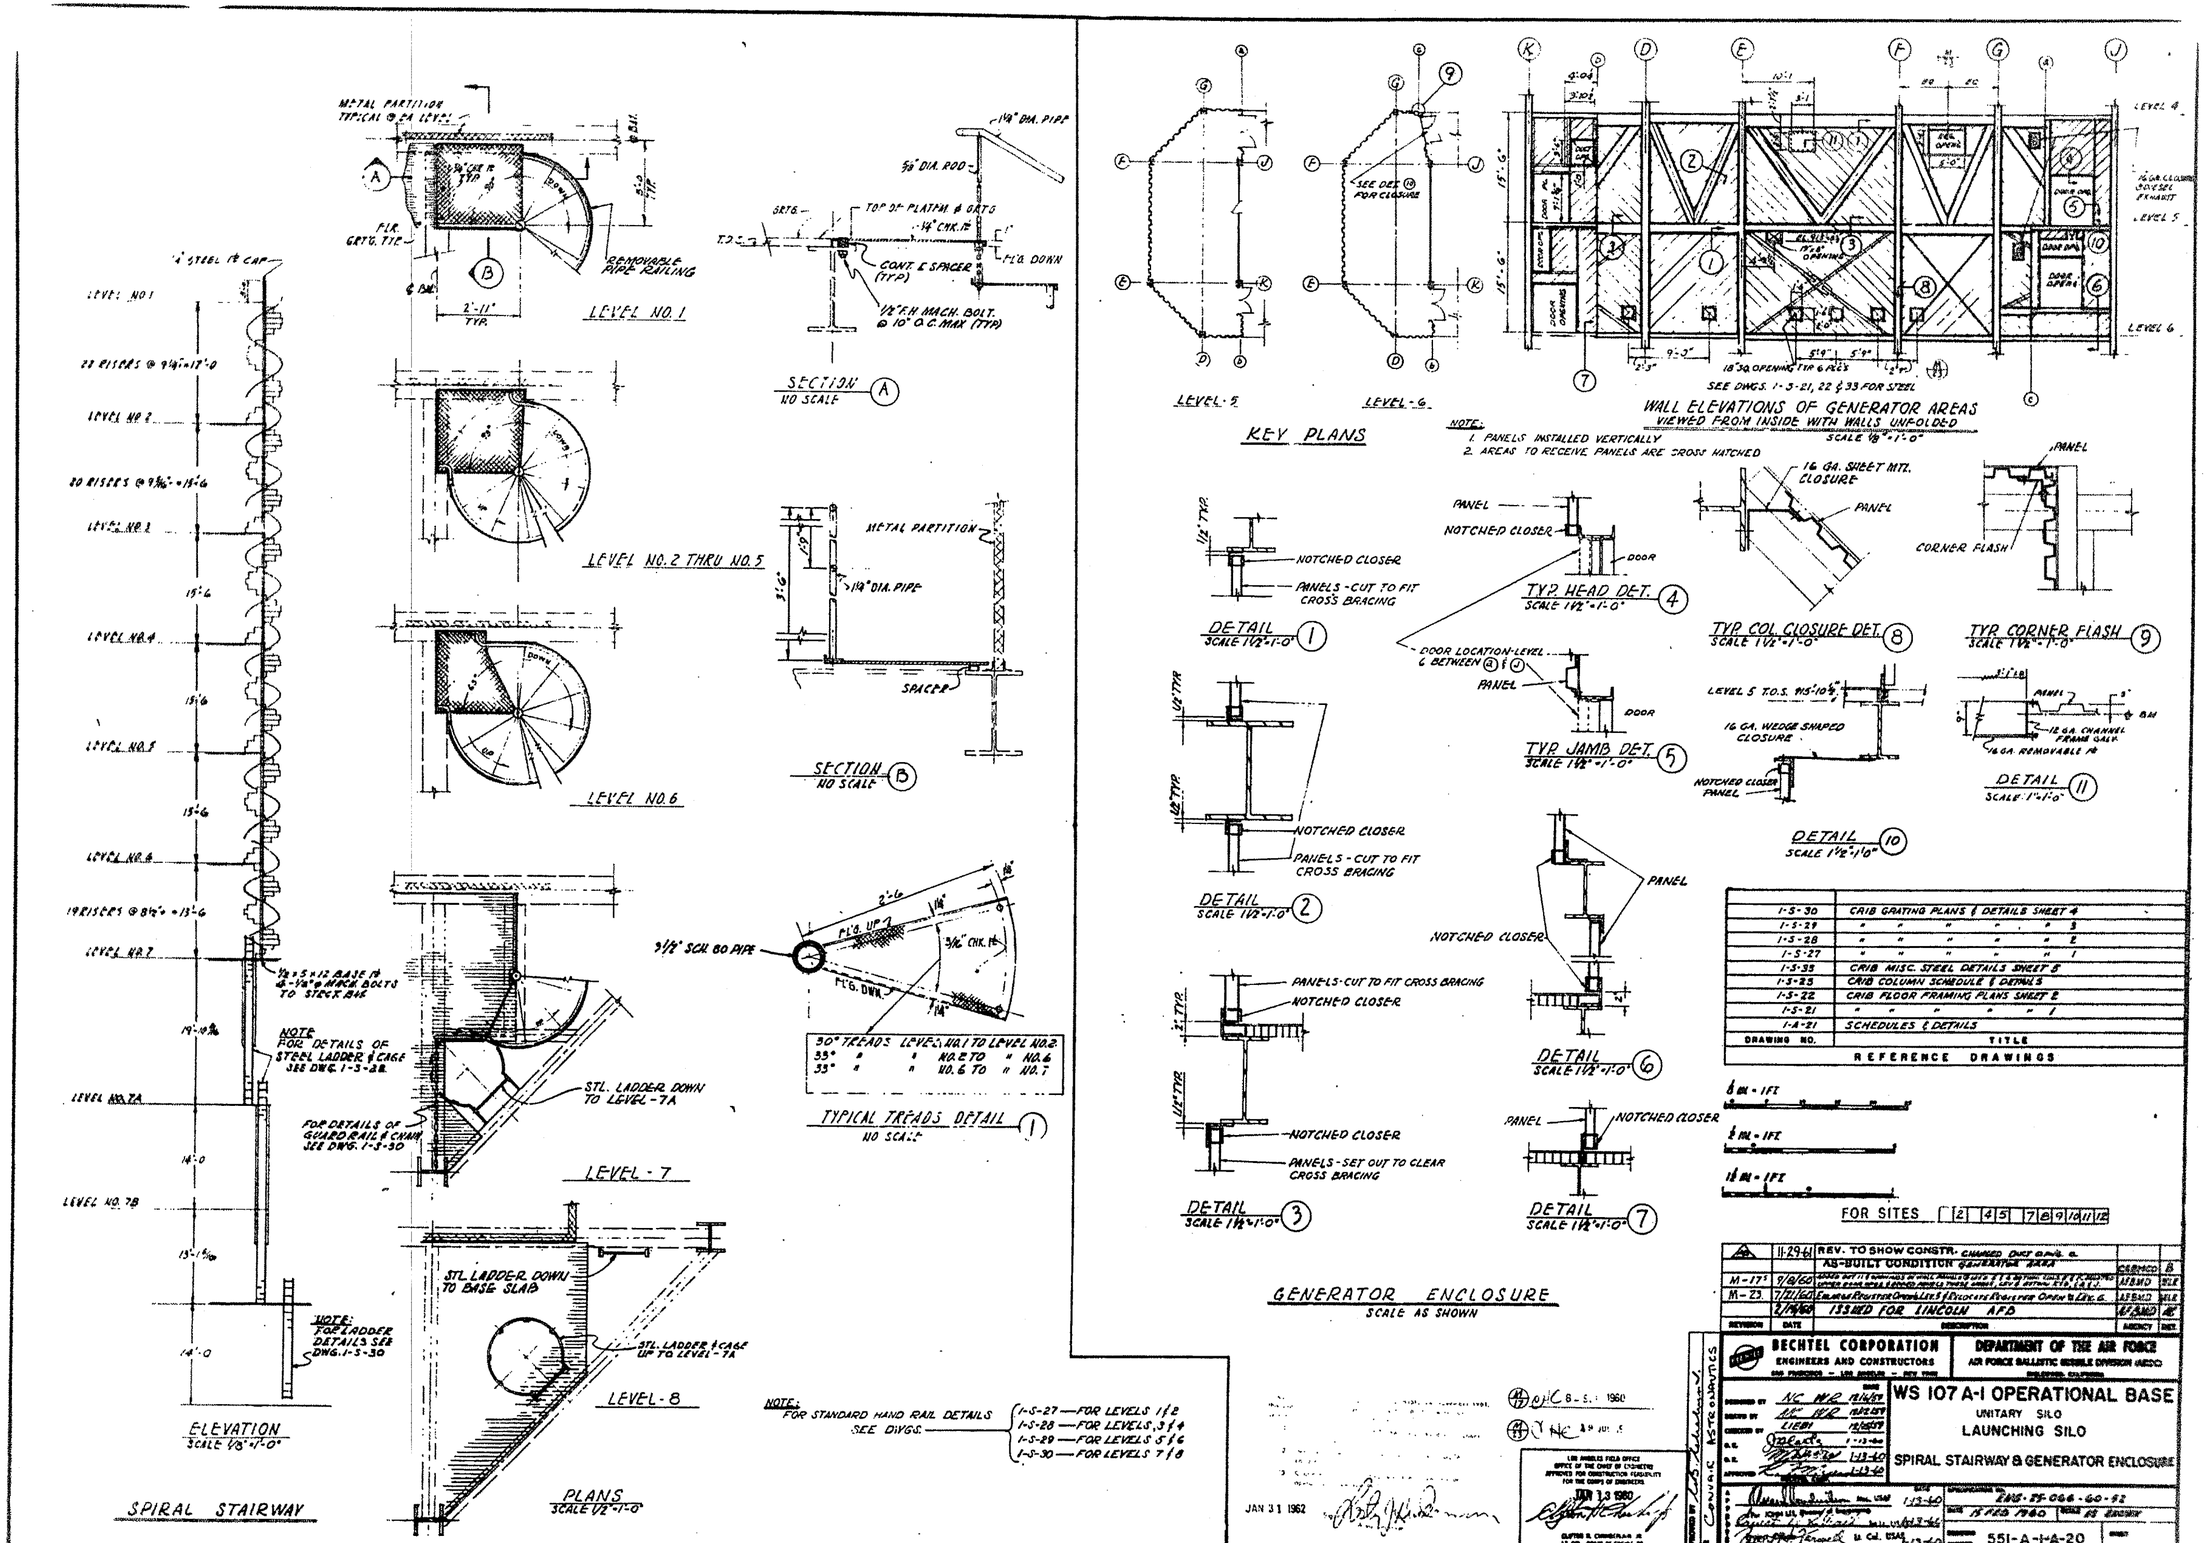

DRAWING NO.	TITLE
1-S-30	CRIB GRATING PLANS & DETAILS SHEET 4
1-S-29	" " " " " 3
1-S-28	" " " " " 2
1-S-27	" " " " " 1
1-S-33	CRIB MISC. STEEL DETAILS SHEET 5
1-S-23	CRIB COLUMN SCHEDULE & DETAILS
1-S-22	CRIB FLOOR FRAMING PLANS SHEET 2
1-S-21	" " " " " 1
1-A-21	SCHEDULES & DETAILS

REFERENCE DRAWINGS

REVISION	DATE	DESCRIPTION	AGENCY	REV.
A	11-29-61	REV. TO SHOW CONSTR. CHANGED DUCT DWG. A. AS-BUILT CONDITION GENERATOR AREA	CSBMCD	B
M-17	9/8/60	[illegible]	AFBMD	SLR
M-23	7/21/60	[illegible]	AFBMD	SLR
	2/19/60	ISSUED FOR LINCOLN AFB	AFBMD	[illegible]

BECHTEL CORPORATION
ENGINEERS AND CONSTRUCTORS
SAN FRANCISCO — LOS ANGELES — NEW YORK

DEPARTMENT OF THE AIR FORCE
AIR FORCE BALLISTIC MISSILE DIVISION (AFSC)
INGLEWOOD, CALIFORNIA

DESIGNED BY NC WR 12/16/59
DRAWN BY NC WR 12/12/59
CHECKED BY LIEBI 12/15/59
D.E. [signature] 1-13-60
D.E. [signature] 1-13-60
APPROVED [signature] 1-13-60

WS 107 A-1 OPERATIONAL BASE
UNITARY SILO
LAUNCHING SILO
SPIRAL STAIRWAY & GENERATOR ENCLOSURE

APPROVED BY [signature] 1-13-60
FOR CONVAIR ASTRONAUTICS
APPROVED [signature] 1-13-60
APPROVED [signature] 1-13-60
APPROVED [signature] 1-13-60

SPECIFICATION NO. ENG-25-066-60-52
DATE 15 FEB 1960
SCALE AS SHOWN
DRAWING NUMBER 551-A-1-A-20
SHEET

JAN 31 1962

LOS ANGELES FIELD OFFICE
OFFICE OF THE CHIEF OF ENGINEERS
APPROVED FOR CONSTRUCTION FEASIBILITY
FOR THE CORPS OF ENGINEERS
JAN 13 1960
CLIFTON R. CHANDLER, JR.
LT. COL., CORPS OF ENGINEERS
DEPUTY FOR ENGINEERING

BMD INDEX NO. SEL 401 THRU 111