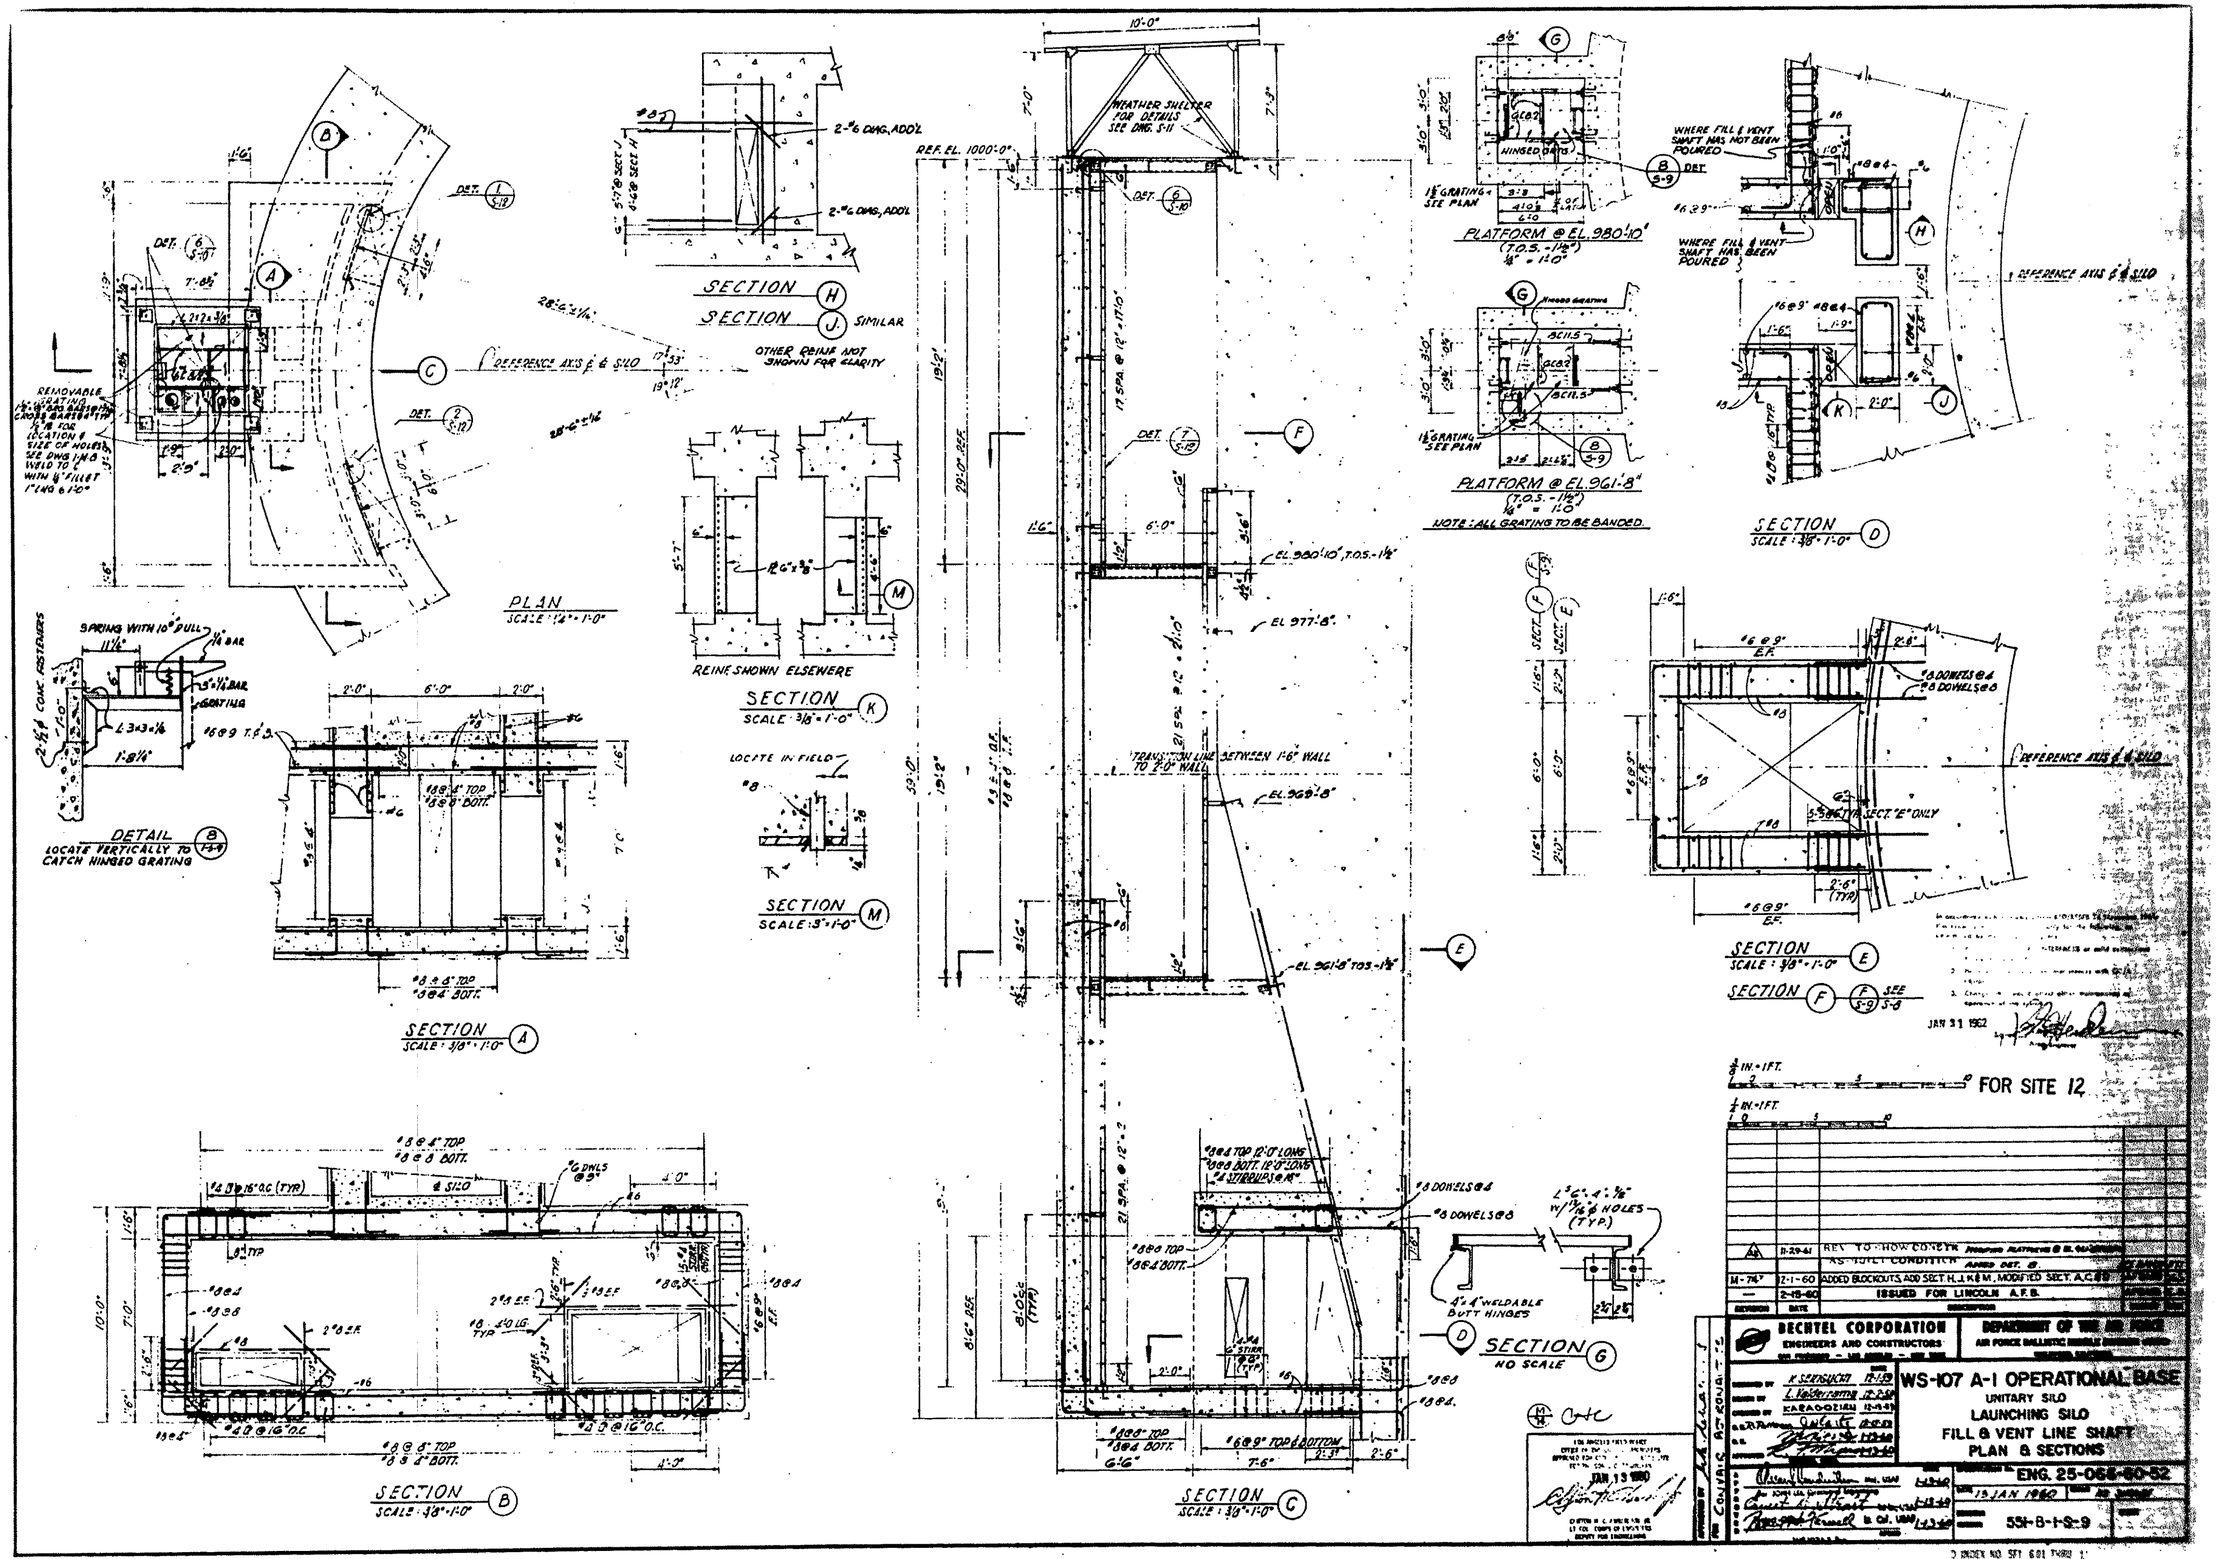
PLAN
SCALE 1/4" = 1'-0"
SECTION H
SECTION J SIMILAR
OTHER REINF NOT SHOWN FOR CLARITY
REINF SHOWN ELSEWERE
SECTION K
SCALE 3/8" = 1'-0"
SECTION M
SCALE 3" = 1'-0"
DETAIL B
LOCATE VERTICALLY TO CATCH HINGED GRATING
SECTION A
SCALE 3/8" = 1'-0"
SECTION B
SCALE 3/8" = 1'-0"
SECTION C
SCALE 3/8" = 1'-0"
SECTION G
NO SCALE
PLATFORM @ EL. 980'-10"
PLATFORM @ EL. 961'-8"
NOTE: ALL GRATING TO BE BANDED.
SECTION D
SCALE 3/8" = 1'-0"
SECTION E
SCALE 3/8" = 1'-0"
SECTION F
FOR SITE 12
JAN 31 1962
11-29-61 REV. TO SHOW CONSTR. AS-BUILT CONDITION
M-74 2-1-60 ADDED BLOCKOUTS, ADD SECT. H, J, K & M, MODIFIED SECT. A, C, B
2-15-60 ISSUED FOR LINCOLN A.F.B.
BECHTEL CORPORATION
ENGINEERS AND CONSTRUCTORS
DEPARTMENT OF THE AIR FORCE
AIR FORCE BALLISTIC MISSILE DIVISION
WS-107 A-1 OPERATIONAL BASE
UNITARY SILO
LAUNCHING SILO
FILL & VENT LINE SHAFT
PLAN & SECTIONS
ENG. 25-066-60-52
13 JAN 1960
551-B-1-S-9
JAN 13 1960