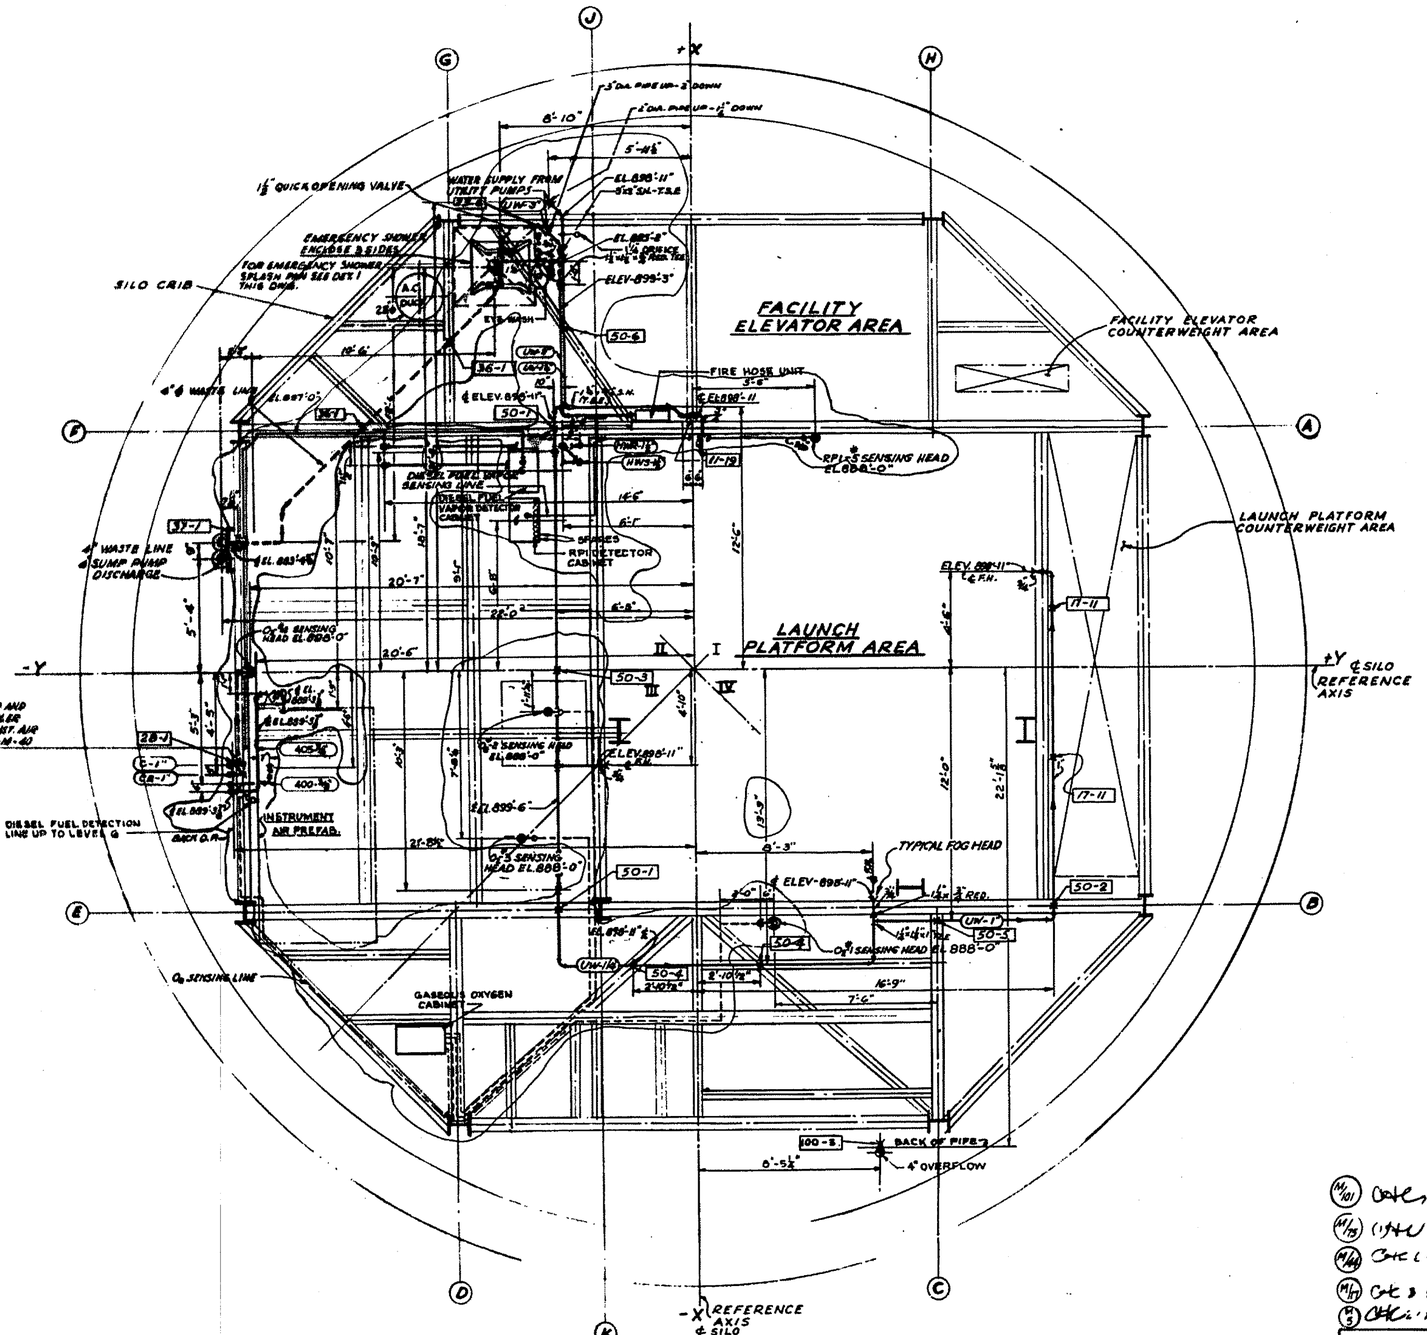

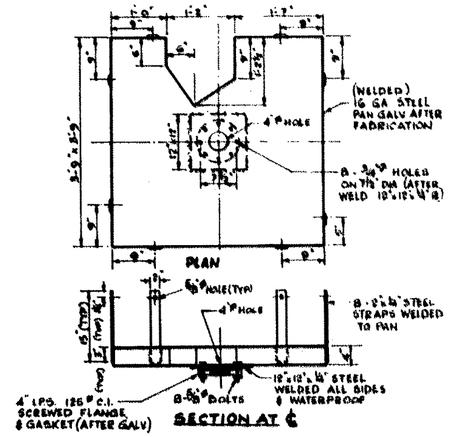

EMERGENCY SHOWER SPLASH PAN
DET. 1

85 THRU 93 & 103	1 AF 164
39, 70 THRU 78, 80, 81	1 AF 183
43-44, 46-48, 49-50, 88-93 & 5 THRU 5A, 100 THRU 102	1 AF 180
20, 24 THRU 30, 32 THRU 38, 40 THRU 42, 98, 99	1 AF 181
1 THRU 18, 21 THRU 23, 60 & 97	1 AF 80
HANGER NOS	DETAIL DWG NO

HANGER DETAIL INDEX

¾ IN = 1 FT.

DRAWING NO.	TITLE
1-M-74	H.V.&A.C. EQUIP & DUCTWORK PLAN AT LEVEL 3 & 7
1-M-88	H.V.&A.C. FACILITY PIPING AT LEVEL 8
1-M-84	H.V.&A.C. LEGEND & SYMBOLS
1-M-80	H.V.&A.C. FACILITY PIPING SUPPORT & HANGER DETAILS
1-M-100	COMPRESSED AIR FLOW DIAGRAM
1-M-104	H.V.&A.C. FACILITY PIPING MISC. SECTIONS & DETAILS
1-M-40	INSTRUMENT AIR PREFAB PLAN & ELEV.
1-M-97	H.V.&A.C. CHILLED WATER FLOW DIAGRAM
1-M-92	H.V.&A.C. FACILITY PIPING PLAN AT LEVEL 6
1-M-103	UTILITY WATER-FLOW DIAGRAM

REFERENCE DRAWINGS

FOR SITES [ ] [ ] [ ] [ ] [ ] [ ] [ ] [ ] [ ] [ ] [ ] [ ]

REVISION	DATE	DESCRIPTION	AGENCY	DATE
A	12-18-61	REVISED TO SHOW CONSTRUCTION AS-BUILT CONDITION; RELOCATED DRAIN FROM EMERGENCY SHOWER & RELATED HANGERS; REVISED LINES 400-¾, 405-¾, UW-1½; DETECTOR CABINETS & SENSING LINES	G.E. BMCO	H.H.
M-101	4-27-61	ADDED 4" OVERFLOW LINE & SHOP 108-3, REV'D HANGER DETAIL INDEX	AF BMD	H.H.
M-75	12-21-60	REV'D HANGERS, PIPING & DWG TO AGREE WITH HANGER DETAILS	AF BMD	W.H.
M-44	10-7-60	DELETED CWS & CWR-8" LINES & DIM. & HGRS 48-8 & 48-9	AF BMD	H.H.
M-17	9-8-60	ADDED EMERGENCY SHOWER SPLASH PAN DET. LOCATED HWS & HWR PIPING & ADDED PIPING CALLOUTS & LOCATION DIMS. REV'D FOG SPRAY SYSTEM. UW-2½" WAS UW-2½". LOCATED EMERG. SHOWER, RPI DETECTOR CABINET & GASEOUS OXY. CABINET. LOCATED PIPING TO INSTRUMENT PREFAB, REV'D. EXISTING AND ADDED NEW PIPE SUPPORTS.	AF BMD	H.H.
M-5	4-13-60	DIESEL FUEL & RPI-1 & VAPOR SENSING LINES ADDED SENSING LINE NOS ADDED & HGRS LOCATED & DIM.	AF BMD	H.H.
—	2-15-60	ISSUED FOR LINCOLN A.F.B.	AF BMD	E.D.

BECHTEL CORPORATION
ENGINEERS AND CONSTRUCTORS
SAN FRANCISCO - LOS ANGELES - NEW YORK

DEPARTMENT OF THE AIR FORCE
AIR FORCE BALLISTIC MISSILE DIVISION (ARDC)
INGLEWOOD, CALIFORNIA

WS 107 A-1 OPERATIONAL BASE
UNITARY SILO
LAUNCHING SILO
H V & A C FACILITY PIPING
PLAN AT LEVEL 7

ENG. 25-066-60-52
13 JAN 1960
551-K-1-M-79

CONVAIR ASTRONAUTICS